


# GRANT COUNTY

## Survey Monument Record

TYPE OF MONUMENT GRANT COUNTY ALUMINUM MON.  
STATE PLANE COORDINATES: N \_\_\_\_\_  
E \_\_\_\_\_  
ELEVATION — M.S.L. DATUM: \_\_\_\_\_  
THETA ANGLE: \_\_\_\_\_  
FIELD BOOK: 94-16  
PAGE 15

CORNER NO. 107  
SECTION 34  
TOWN 4 N  
RANGE 5 W  
NW COR.

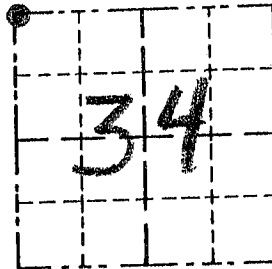


## BASIS FOR MONUMENT LOCATION

(Use reverse side if necessary)

Show info such as: History of corner, with reference to Vol. and pg., dates, surveyor; exact description of monument replaced; if location computed, by taped or EDM traverse; landowner, remarks, etc.

SEAL:

SET A GRANT CO. ALUM.  
MONUMENT AT THE OCCUPIED  
CORNER. FOUND NO RECORD  
OF THE COR. SINCE  
ORIGINAL SURVEYS; VERIFIED  
BY EDM TRAVERSE

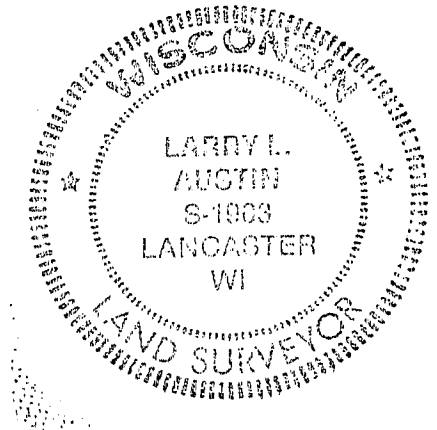

CERTIFIED CORRECT

Larry L. Austin  
Registered Land Surveyor  
DATE: 11/1/94

## TIE SKETCH

Show at least three (3) ties and monument

