


GRANT COUNTY

Section Summary

11 - 4N - 5W
SECTION TOWN RANGE

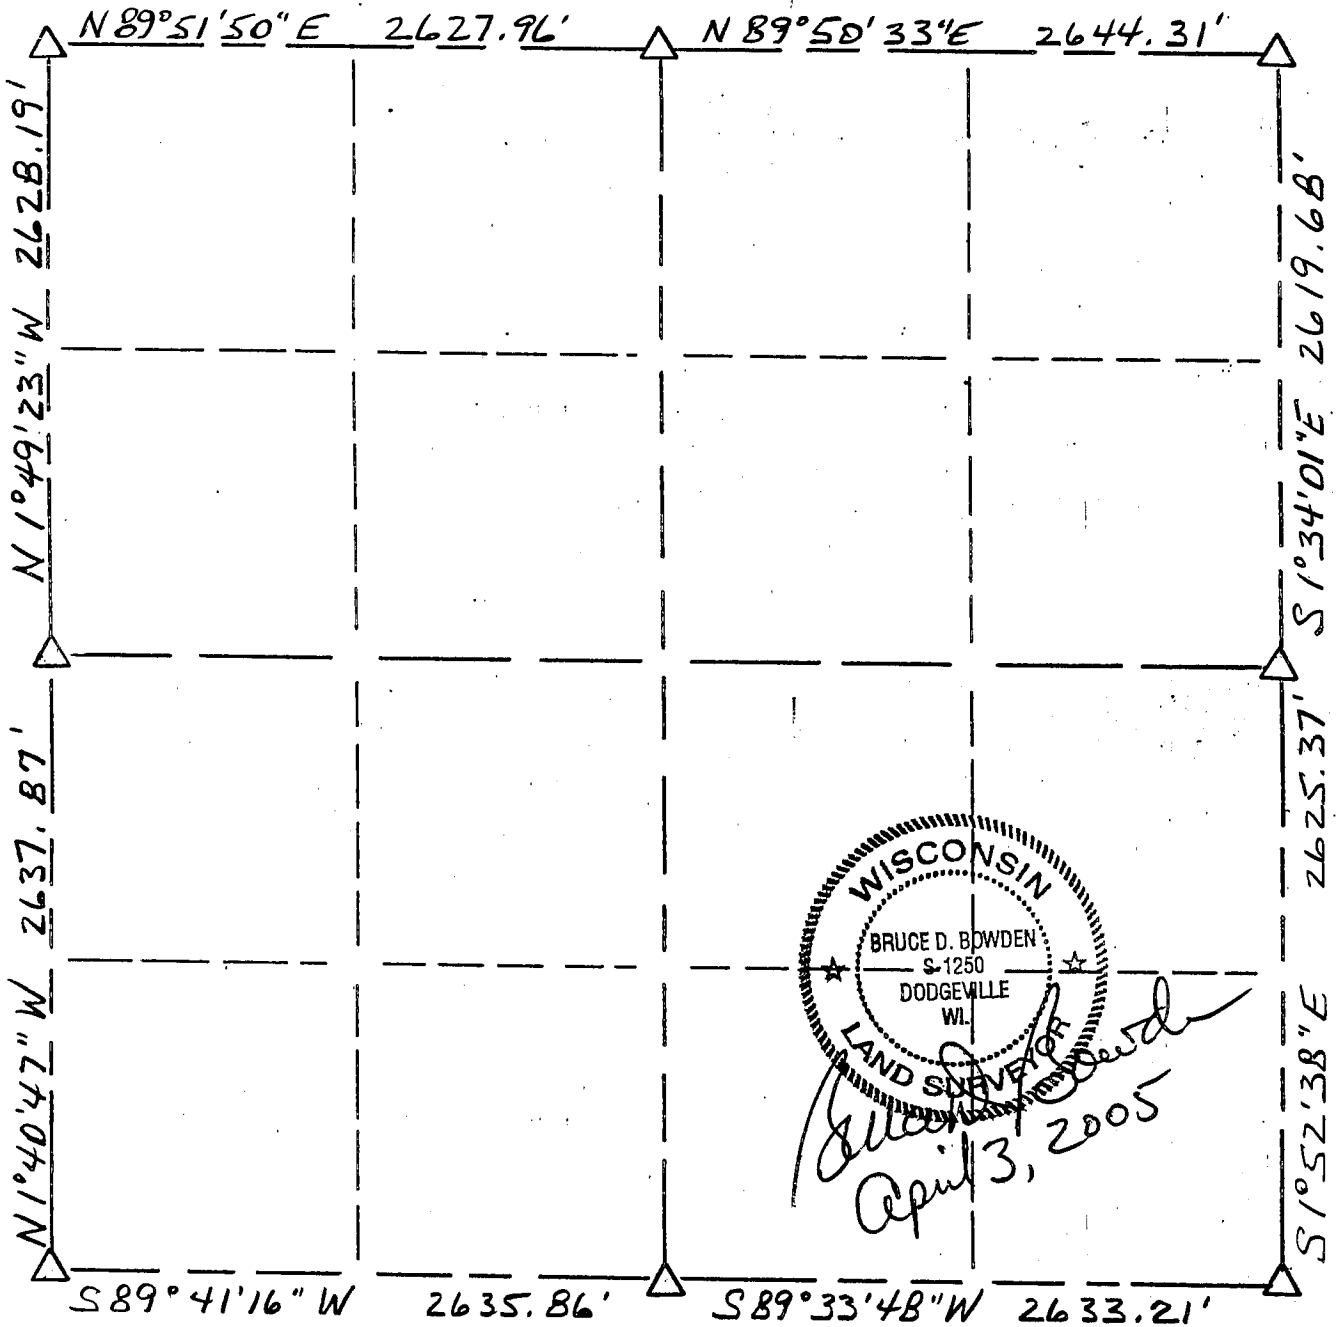

WISCONSIN
BRUCE D. BOWDEN
S-1250
DODGEVILLE
WI.
LAND SURVEYOR
Bruce D. Bowden
April 3, 2005



LEGEND

- △ COUNTY MONUMENT
- STONE OR CONCRETE MONUMENT
- OTHER (specify) _____
- _____
- _____
- _____
- _____

NOTE:

Relationships of all section corners to other section corners shall be shown hereon by bearing and distance or grid coordinates
Show or describe bearing reference