

GRANT COUNTY CERTIFIED LAND CORNER

CERTIFICATE:

I, LARRY L. AUSTIN, DO HEREBY CERTIFY THAT ON TENTH DAY OF OCTOBER, 1999, I FOUND EVIDENCE OF THE NORTH 1/4 CORNER OF SECTION 01, TOWN 4 NORTH, RANGE 6 WEST, OF THE FOURTH PRINCIPAL MERIDIAN, AND I RE-ESTABLISHED SAID CORNER ACCORDING TO THE WISCONSIN STATUTES AS SHOWN AND DESCRIBED HEREON.


DATED THIS FIFTEENTH DAY OF OCTOBER, 1999

Larry L. Austin
LARRY L. AUSTIN S-1903



SEAL

CORNER NUMBER 02

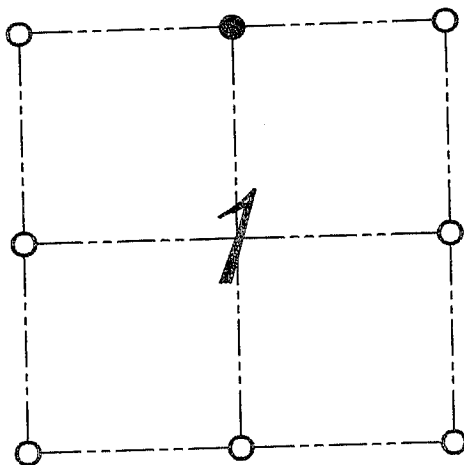

● = CORNER LOCATION
NORTH 1/4 CORNER OF
SECTION 1, T 4 N R 6 W
TOWN OF BLOOMINGTON

HISTORY OF ORIGINAL CORNER ESTABLISHMENT:

CORNER WAS SET IN 1832 BY SIBLEY. IN 1875 JOEL BARBER FOUND A STONE SET BY JAMES WILSON. THOMAS BUCK SET THE CORNER IN 1998.

DESCRIPTION OF CORNER EVIDENCE FOUND:

I WAS UNABLE TO FIND THE STONE DO TO A HUGE CUT FOR THE HIGHWAY. I FOUND BUCK'S CORNER AND ALSO FOUND IT TO BE INCORRECT. I FOUND OCCUPATIONAL EVIDENCE ALONG THE NORTH LINE OF THE NE 1/4 OF SECTION 1 AND A FENCE WEST ALONG THE NORTH LINE OF THE NW 1/4 FOR NORTHING. I HELD BUCK'S EASTING AS THE BEST EVIDENCE. VERIFIED THIS LOCATION USING E.D.M. AND G.P.S. METHODS.

DESCRIPTION OF CORNER AND WITNESS MONUMENTS, REFERENCES AND ACCESSORIES USED TO PERPETUATE THE ORIGINAL OR RE-ESTABLISHED LOCATION OF THIS CORNER:
WITNESS TO THE CORNER LOCATION: BOBBY SEDGWICK ; SHELBY BLINDERT

SKETCH:

LEGEND

- NUMBER 8 X 30" REBAR SET WITH GRANT COUNTY ALUMINUM CAP
- NUMBER 4 X 24" REBAR SET WITH RED PLASTIC CAP
- NUMBER 6 REBAR FOUND
- *-* EXISTING FENCE LOCATION

