


**U.S. PUBLIC LAND SURVEY MONUMENT RECORD – GRANT COUNTY, WI**

**Summary of Section 10, Town 4 North, Range 6 West, Town of Glen Haven**



S 88°31'29" E 2626.56'  
(40ch=2640')

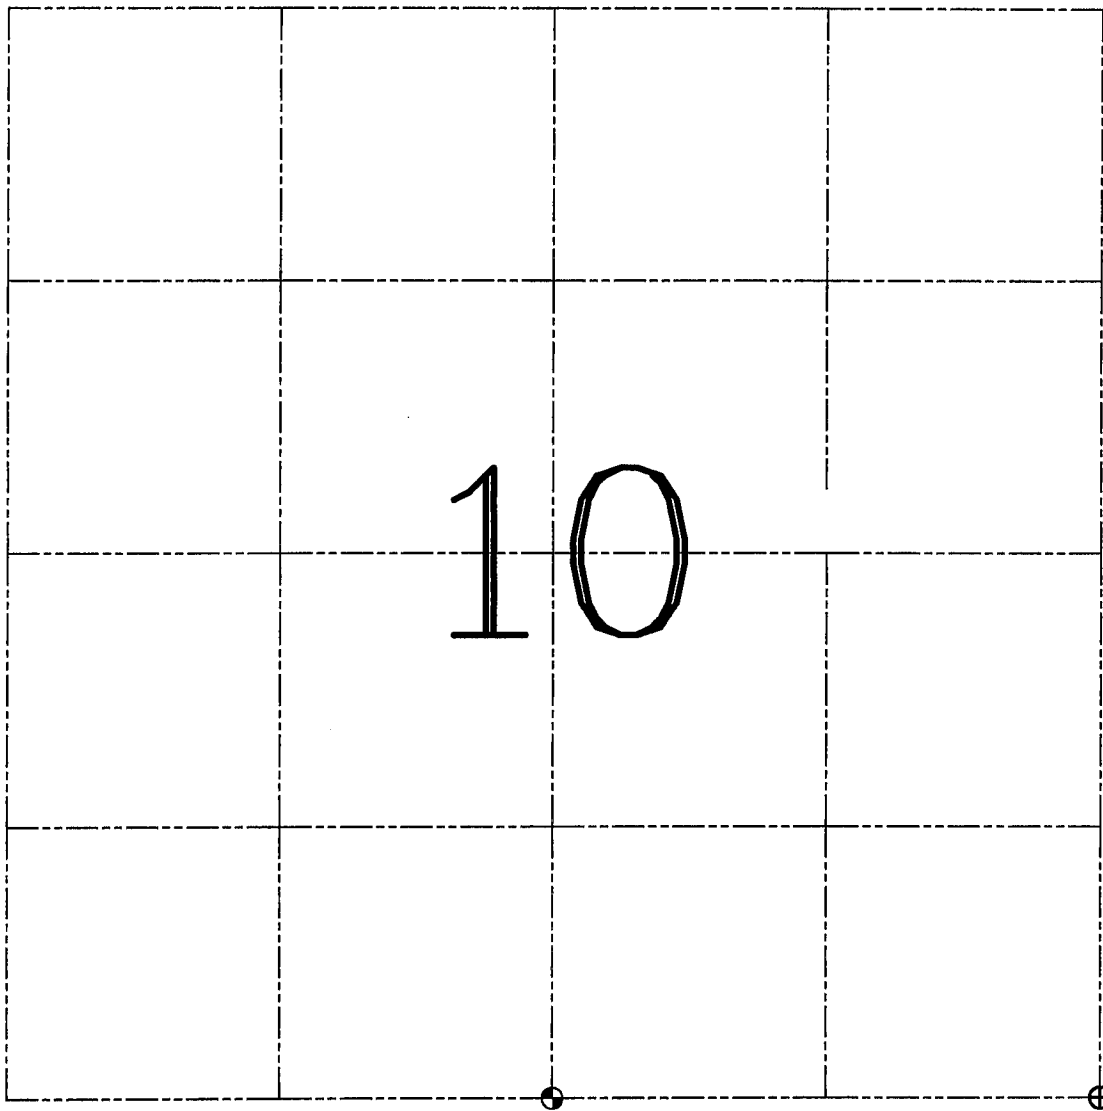

**LEGEND**

- ⊕ No. 8 rebar found with Grant County Aluminum Cap
- ⊙ No. 8 x 30" rebar set with Grant County Aluminum Cap – wt=2.67#/l.f.
- ( ) Recorded as
- \*— Approximate location of existing fence

Relationship of all section corners to other section corners shall be shown hereon by bearing and distance or grid coordinates. Bearing reference shown below.

Dated this 30th day of December, 2005

*Larry L. Austin*  
Larry L. Austin S-1903

Bearings referenced to the South line of the Southeast Quarter of this Section, which is assumed to bear S 88°31'29" E.



**Austin Engineering LLC**

4211 HWY 81 E, LANCASTER, WI 53813  
PHONE 608-723-6363 FAX 608-723-6702

JOB NUMBER: 01S044  
FIELDBOOK: TDSR, 2113  
G:\T4NR6W\15  
H:\TIE\T4NR6W\10SUM

DRAWN BY: SW AUSTIN  
APPROVED: LL AUSTIN

SKETCH NOT TO SCALE