


SECTION CORNER TIE SHEET INDEX

T. 5 N., R. 1 W

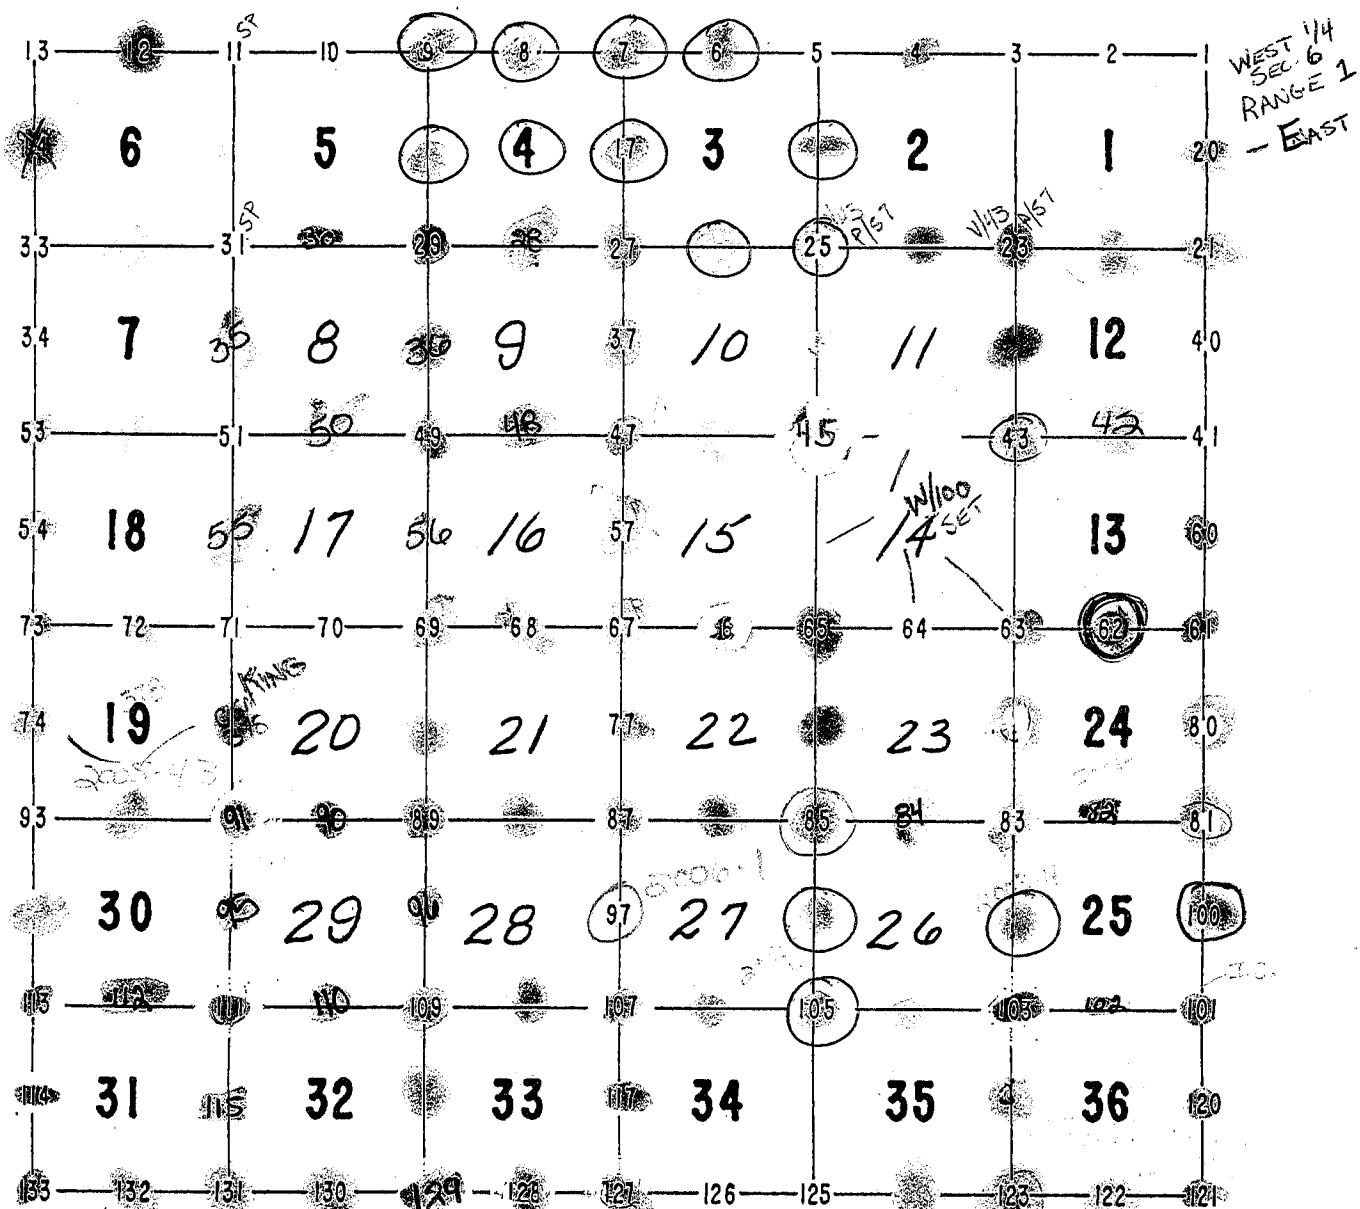

104-1-06

57