

GRANT COUNTY CERTIFIED LAND CORNER


CORNER NO. 54

CERTIFICATE:

I, LARRY L. AUSTIN, DO HEREBY CERTIFY THAT ON NINETEENTH DAY OF MARCH, 1999, I FOUND NO EVIDENCE OF THE WEST 1/4 CORNER OF SECTION 18, TOWN 5 NORTH, RANGE 1 WEST, OF THE FOURTH PRINCIPAL MERIDIAN, AND I RE-ESTABLISHED SAID CORNER ACCORDING TO THE WISCONSIN STATUTES AS SHOWN AND DESCRIBED HEREON.

DATED THIS NINTH DAY OF APRIL, 1999

Larry L. Austin
LARRY L. AUSTIN S-1903

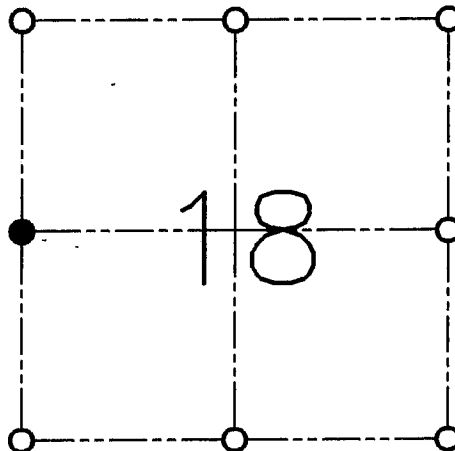

● = CORNER LOCATION

**WEST 1/4 CORNER OF
SECTION 18, T 5 N R 1 W
TOWN OF CLIFTON**

HISTORY OF ORIGINAL CORNER ESTABLISHMENT:

CORNER WAS NEVER ORIGINALLY SET.

DESCRIPTION OF CORNER EVIDENCE FOUND:

I FOUND NO EVIDENCE OF THE CORNER. I SET THE CORNER THE ON THE EAST LINE OF SECTION 13 AT PROPORTIONAL RECORDED OFFSET FROM THE EAST 1/4 OF SECTION 13, T5N R2W. VERIFIED THIS LOCATION USING E.D.M. AND G.P.S. METHODS.

DESCRIPTION OF CORNER AND WITNESS MONUMENTS, REFERENCES AND ACCESSORIES USED TO PERPETUATE THE ORIGINAL OR RE-ESTABLISHED LOCATION OF THIS CORNER:

WITNESS TO THE CORNER LOCATION:
BOBBY SEDGWICK
SHELBY BLINDERT

SKETCH:

N 02°42'30" W 117.51'

N 06°21'19" W 56.53'

BETWEEN SECTION CORNERS
= N 00°09'14" E 21.12'

LEGEND

- NO. 8 X 30" REBAR SET WITH GRANT COUNTY ALUMINUM CAP
- NO. 4 X 24" REBAR SET WITH RED PLASTIC CAP
- ×× EXISTING FENCE
- ▲ D.O.T. MONUMENT FOUND (SW CORNER BRIDGE)

