

GRANT COUNTY

Survey Monument Record

GRANT Co.

TYPE OF MONUMENT ALUM. MONUMENT

STATE PLANE COORDINATES: N _____
E _____

ELEVATION — M.S.L. DATUM: _____

THETA ANGLE: _____

FIELD BOOK: 9321

PAGE _____

CORNER NO. 91
SECTION 29
TOWN 5 N
RANGE 1 W




LOCATION
(Indicated by "●")

BASIS FOR MONUMENT LOCATION

(Use reverse side if necessary)

Show info such as: History of corner, with reference to Vol. and pg., dates, surveyor; exact description of monument replaced; if location computed, by taped or EDM traverse; landowner, remarks, etc.

SEAL:

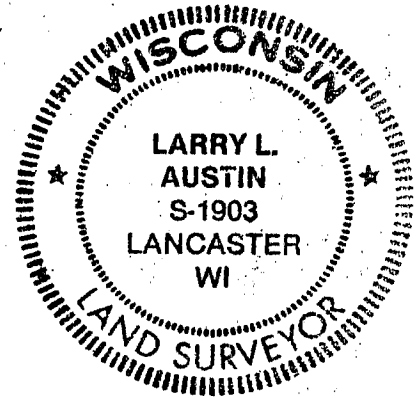

NO RECORD FOUND OF CORNER SINCE ORIG SURVEYS; SET CORNER AT OCCUPIED LOCATION & VERIFIED BY EDM TRAVERSE OF THE AREA.

CERTIFIED CORRECT

Larry L. Austin
Registered Land Surveyor


DATE: 4/5/94

TIE SKETCH

Show at least three (3) ties and monument

LEGEND

- GRANT COUNTY ALUM. MON. SET
- 3/8" x 12" SPIKES SET = TIES FLUSH
- EXISTING FENCE

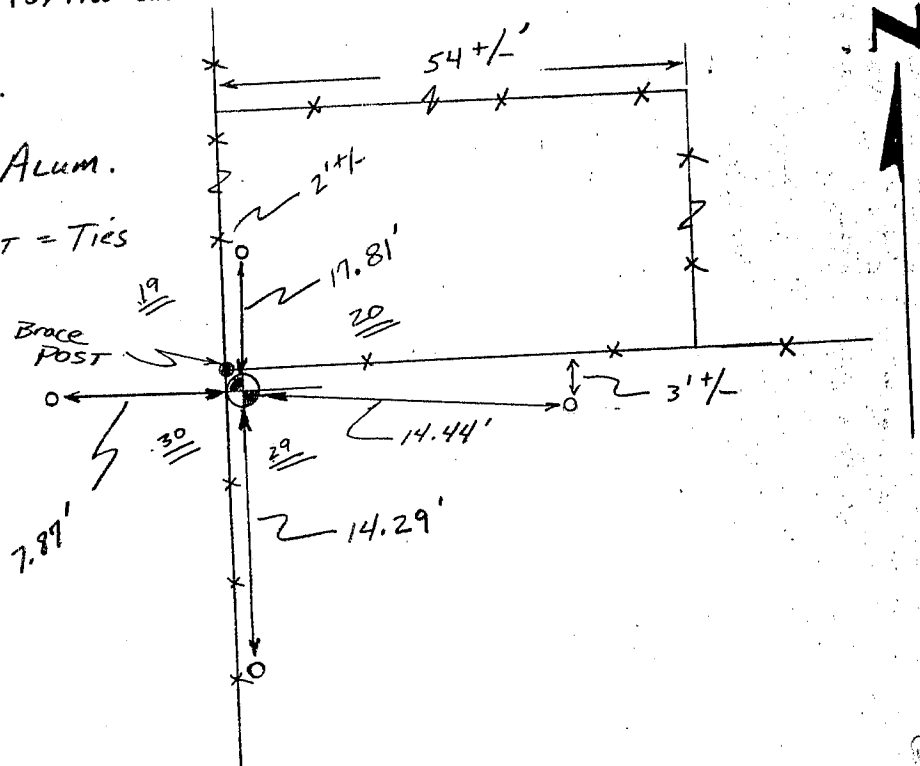

NO SCALE