


# U.S. PUBLIC LAND SURVEY MONUMENT RECORD

Section 30, Town 5 North Range 1 West, Town of Clifton, Grant County, Wisconsin

## CERTIFICATE

I, Larry L. Austin, do hereby certify that the corner location on this record was determined by me and/or under my direct supervision and that this U.S. public land survey monument record is correct and complete to the best of my knowledge and belief.

*Larry L. Austin*  
 Larry L. Austin, S-1903

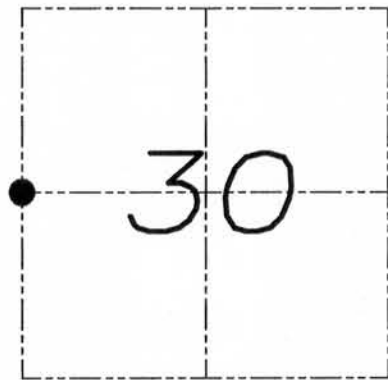

● = CORNER LOCATION

## HISTORY OF CORNER


Corner was originally set in 1832 by Harvey Parke. In 1992 John Halverson set and tied this corner. No other record of this corner was found.

## CORNER EVIDENCE FOUND

I found an existing 1 1/4" rebar set by Halverson. The ties were destroyed during fence construction. I set new ties as shown below and verified its location with EDM and GPS methods.

DESCRIPTION OF CORNER AND WITNESS MONUMENTS, references and accessories used to perpetuate the original or re-established location of this corner. Witnesses to monument location Bobby Sedgwick & Brad Digman & Shelby Blindert

## SKETCH:

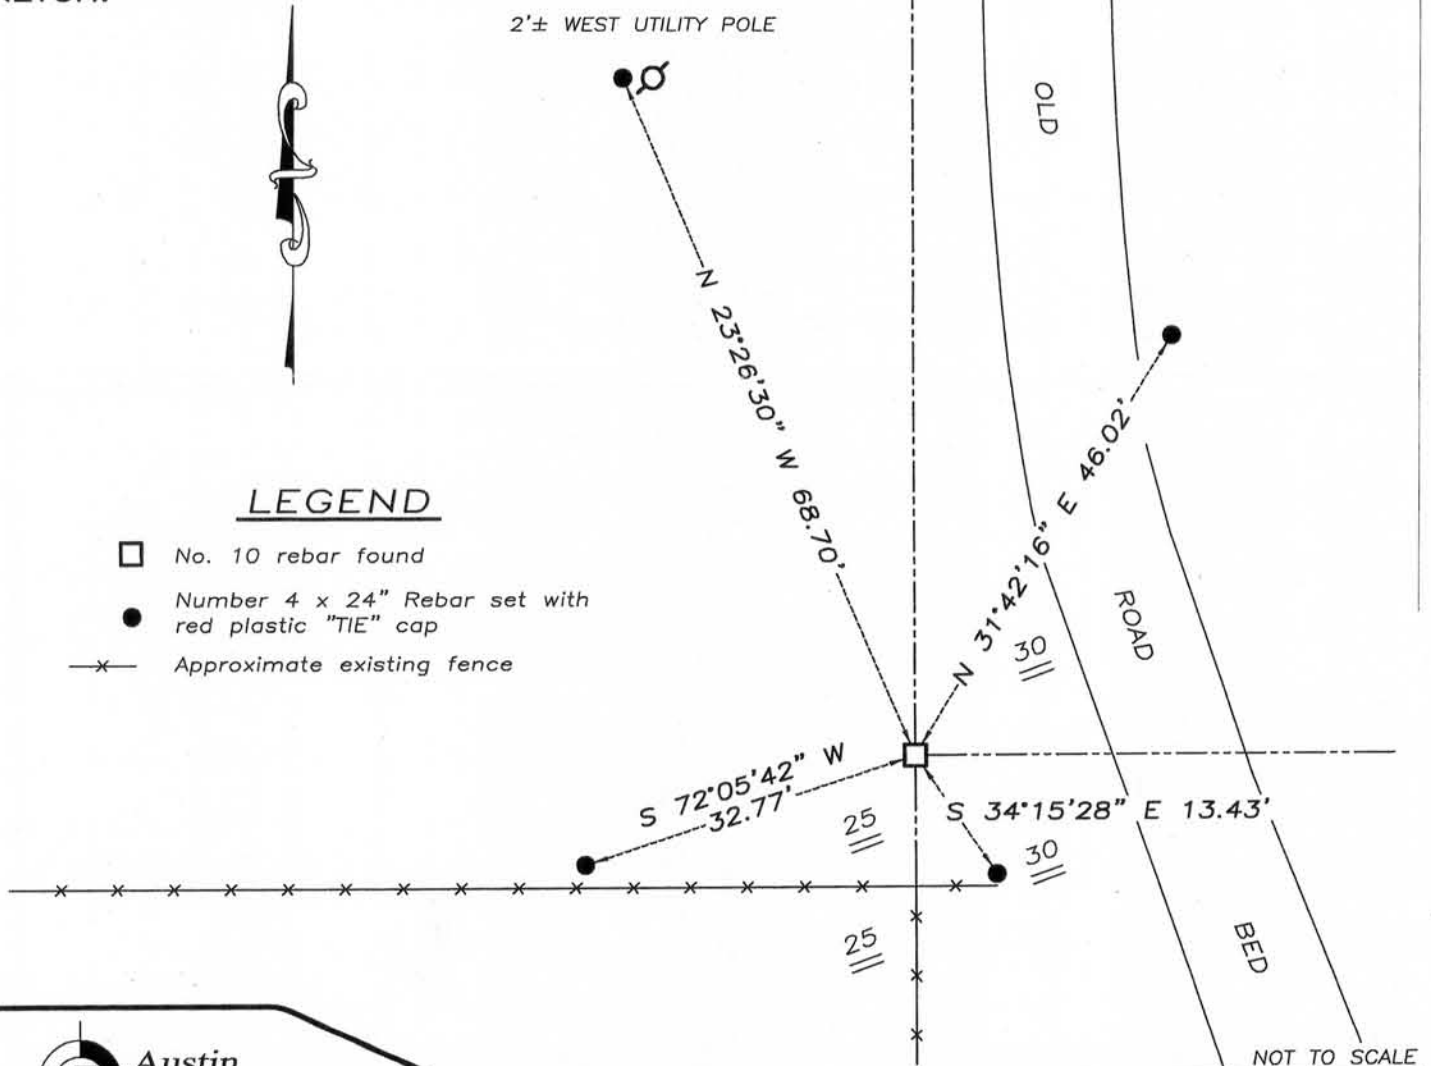

**Austin Engineering LLC**  
 austinengineeringllc.com  
 4211 HWY 81 E, LANCASTER, WI 53813  
 PHONE: 608-723-6363 FAX: 608-723-6702

JOB NUMBER 10S013-DANZ  
 FIELDBOOK: TDSR, 2911  
 G:\T5NR1W\32  
 H:\TIE\T5NR1W\94


DRAWN BY: SW AUSTIN  
 APPROVED: LL AUSTIN

# U. S. PUBLIC LAND SURVEY MONUMENT RECORD

**INSTRUCTIONS:** This record shall show the location of the corner and shall include all of the following nine elements (a through i).

- (a) Identify the corner by reference to the U.S. public land survey system.  
 ⊕ = Corner monument restored.

WEST 1/4 CORNER  
 SECTION 30, T5N, R1W  
 TOWN OF CLIFTON  
 SET 1/4" x 30' IRON ROD

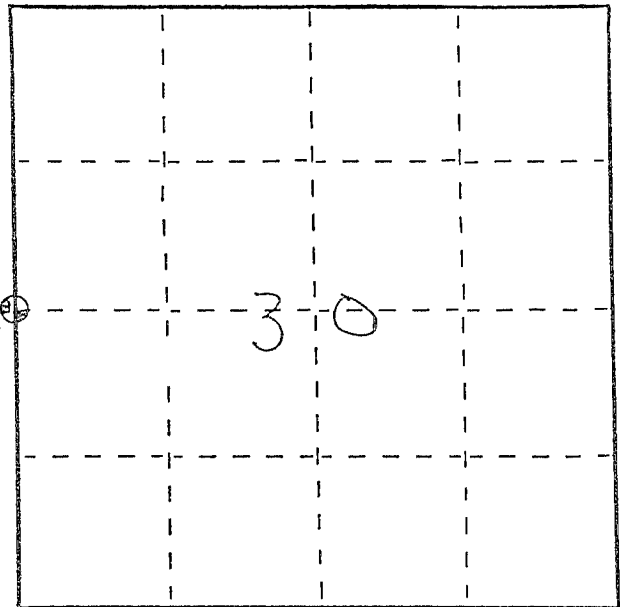


- (b) Describe any record evidence, monument evidence, occupational evidence, testimonial evidence or any other material evidence you considered, and whether the monument was found or placed.

SURVEY COMPLETED BY BARBER (BOOK B, P. 555) SHOWS E 1/4 CORNER SECTION 25-5-2W. I LOCATED A STONE AT THIS CORNER. I SET A 1/4" x 30' IRON ROD AT THE AVERAGE DISTANCE PER ORIGINAL SURVEY OFFSETS AT NORTHWEST AND SOUTHWEST CORNERS OF SECTION 30.

- (c) In the plan view drawing below, provide reference ties to at least 4 witness monuments, or, if the location is within a municipality, to at least 2 witness monuments. (Witness monuments shall be made of concrete, natural stone, iron or other equally durable material.) Describe witness monuments.

- (d) Show a plan view drawing depicting the relevant monuments and reference ties which is sufficient in detail to enable accurate relocation of the corner monument if the corner monument is disturbed. Indicate north.

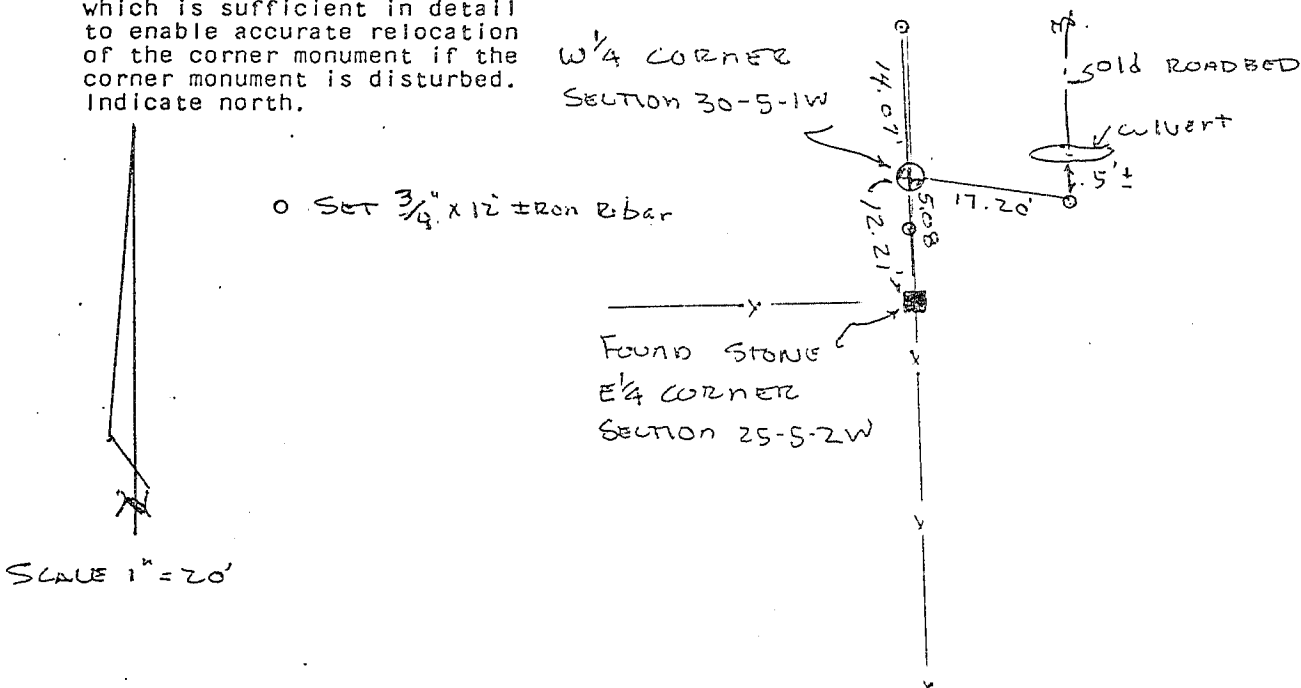

SCALE 1" = 20'



(e) Describe any material discrepancy between the location of the reestablished and the location of that corner as previously restored or reestablished by distance and direction. Show the discrepancy on the plan view drawing under (d), above. Show the distances between the corner as previously restored or reestablished and (1) the corner as restored or reestablished, and (2) to at least 2 of the witness monuments shown on the drawing in (d), above.

None

(f) Was the corner restored through acceptance of (1) an obliterated evidence location, or, (2) a found perpetuated location?

(1) An obliterated evidence location

(g&h) Was the corner reestablished through lost corner proportionate methods? If so, show the method, including the directions and distances to other public land survey corners used as evidence or used for proportioning in determining the corner location?

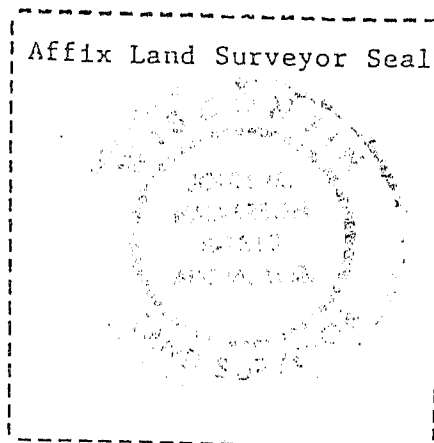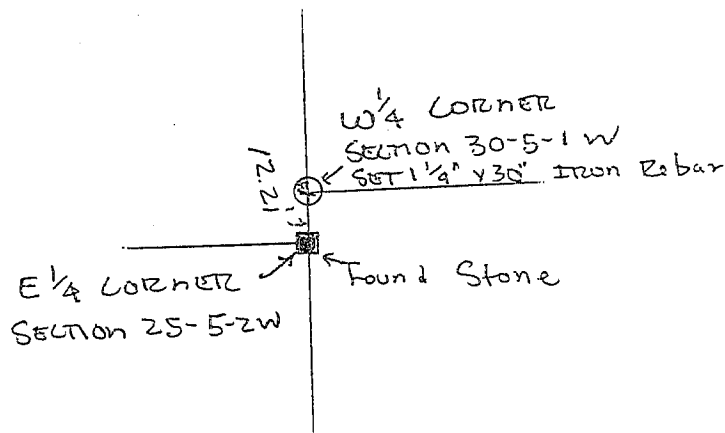

(i) I, John m. Halverson  
 (type or print name) certify that the corner location shown on this record was determined by me or under my direction and control and that this U.S. Public Land Survey Monument Record is correct and complete to the best of my knowledge and belief.

*John m. Halverson*

5/11/92