


# GRANT COUNTY

## Survey Monument Record

TYPE OF MONUMENT GRANT CO. ALUM. MONUMENT  
STATE PLANE COORDINATES: N \_\_\_\_\_  
E \_\_\_\_\_  
ELEVATION — M.S.L. DATUM: \_\_\_\_\_  
THETA ANGLE: \_\_\_\_\_  
FIELD BOOK: 9321  
PAGE \_\_\_\_\_

CORNER NO. 110  
SECTION 29  
TOWN 5N  
RANGE 1W

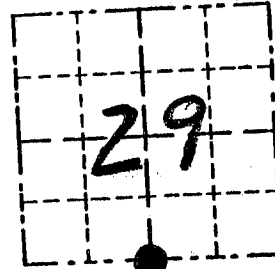

LOCATION  
(Indicated by "●")


### BASIS FOR MONUMENT LOCATION

(Use reverse side if necessary)

Show info such as: History of corner, with reference to Vol. and pg., dates, surveyor; exact description of monument replaced; if location computed, by taped or EDM traverse; landowner, remarks, etc.

SEAL:

NO RECORD OF CORNER FOUND SINCE ORIG. SURVEYS; MONUMENT SET AT MIDWAY BETWEEN SE & SW CORNERS, VERIFIED BY EDM TRAVERSE OF THE AREA.

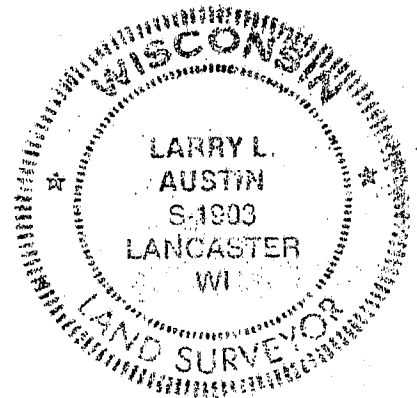


CERTIFIED CORRECT

Larry L. Austin  
Registered Land Surveyor

DATE: 1/5/94

### TIE SKETCH

Show at least three (3) ties and monument

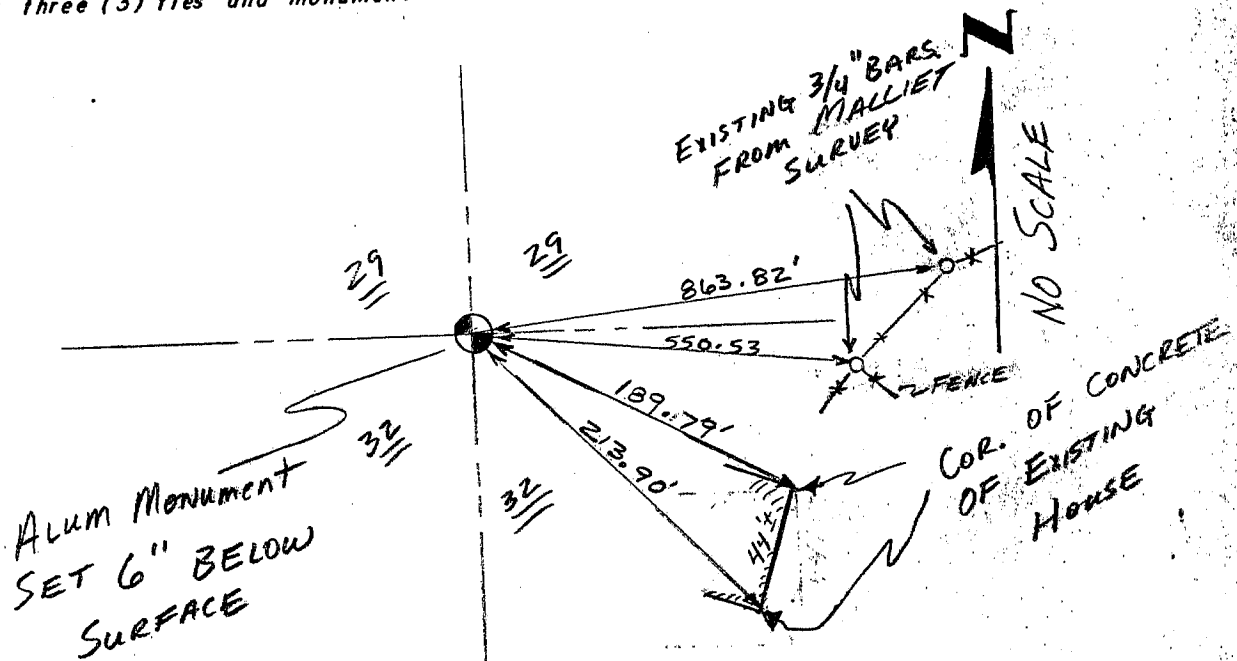

P110