


SECTION SUMMARY SHEET

SECTION 3 T 5 N R 1 W

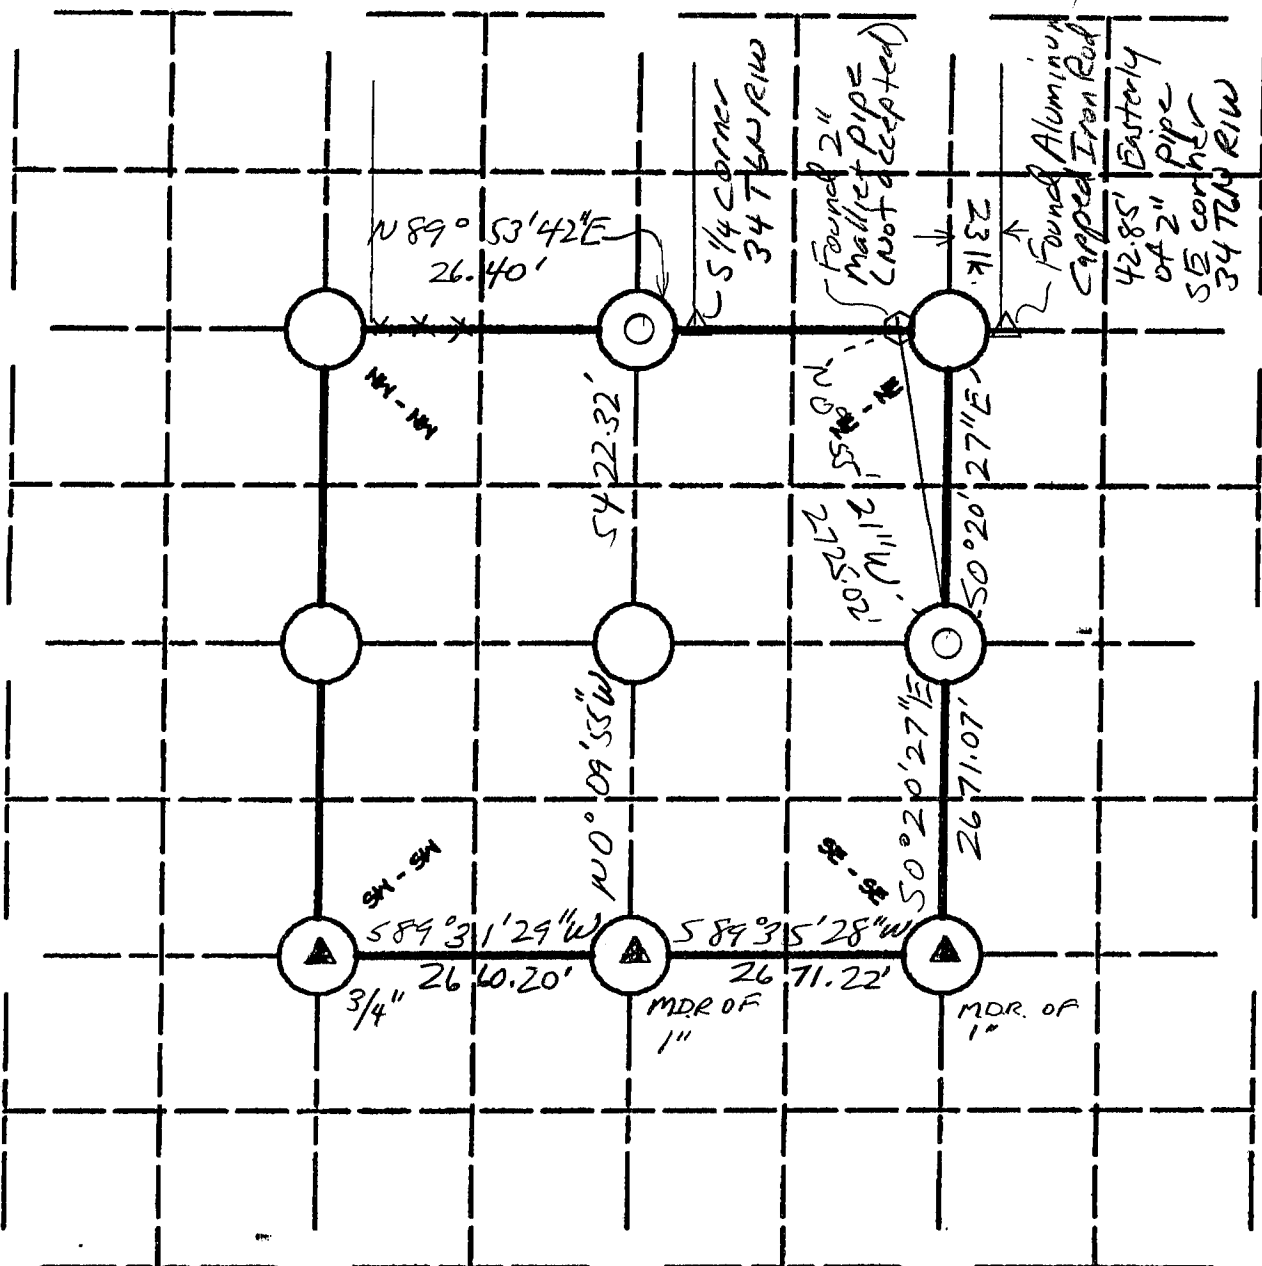

LEGEND:

- O COUNTY MONUMENT SET
- A COUNTY MONUMENT FOUND
- OTHER(Specify)
- ▲ OTHER(Specify) IRON ROD FD.

OTHER(Specify)

OTHER(Specify)

BEARING REF. Grant Co. Coord. System

Michael R. LaRosa
4/10/04

SIGNATURE _____ DATE _____

Horiz. Datum <input type="checkbox"/> NAD 27 <input type="checkbox"/> NAD 83(11) Units <input type="checkbox"/> ENGLISH <input type="checkbox"/> Metric Co-ordinate System <input type="checkbox"/> Geodetic <input type="checkbox"/> State Plane(S. zone) <input type="checkbox"/> Loc. County	The information provided in this box is not req'd, but requested to be provided if available to the surveyor preparing this sheet; otherwise provide reference in accordance with survey plat related to preparation of the sheet. Place coordinates furnished adjacent to the corner(s) on section sketch above.
--	--