


GRANT COUNTY

Section Summary

$\frac{27}{SECTION} - \frac{5N}{TOWN} - \frac{1W}{RANGE}$

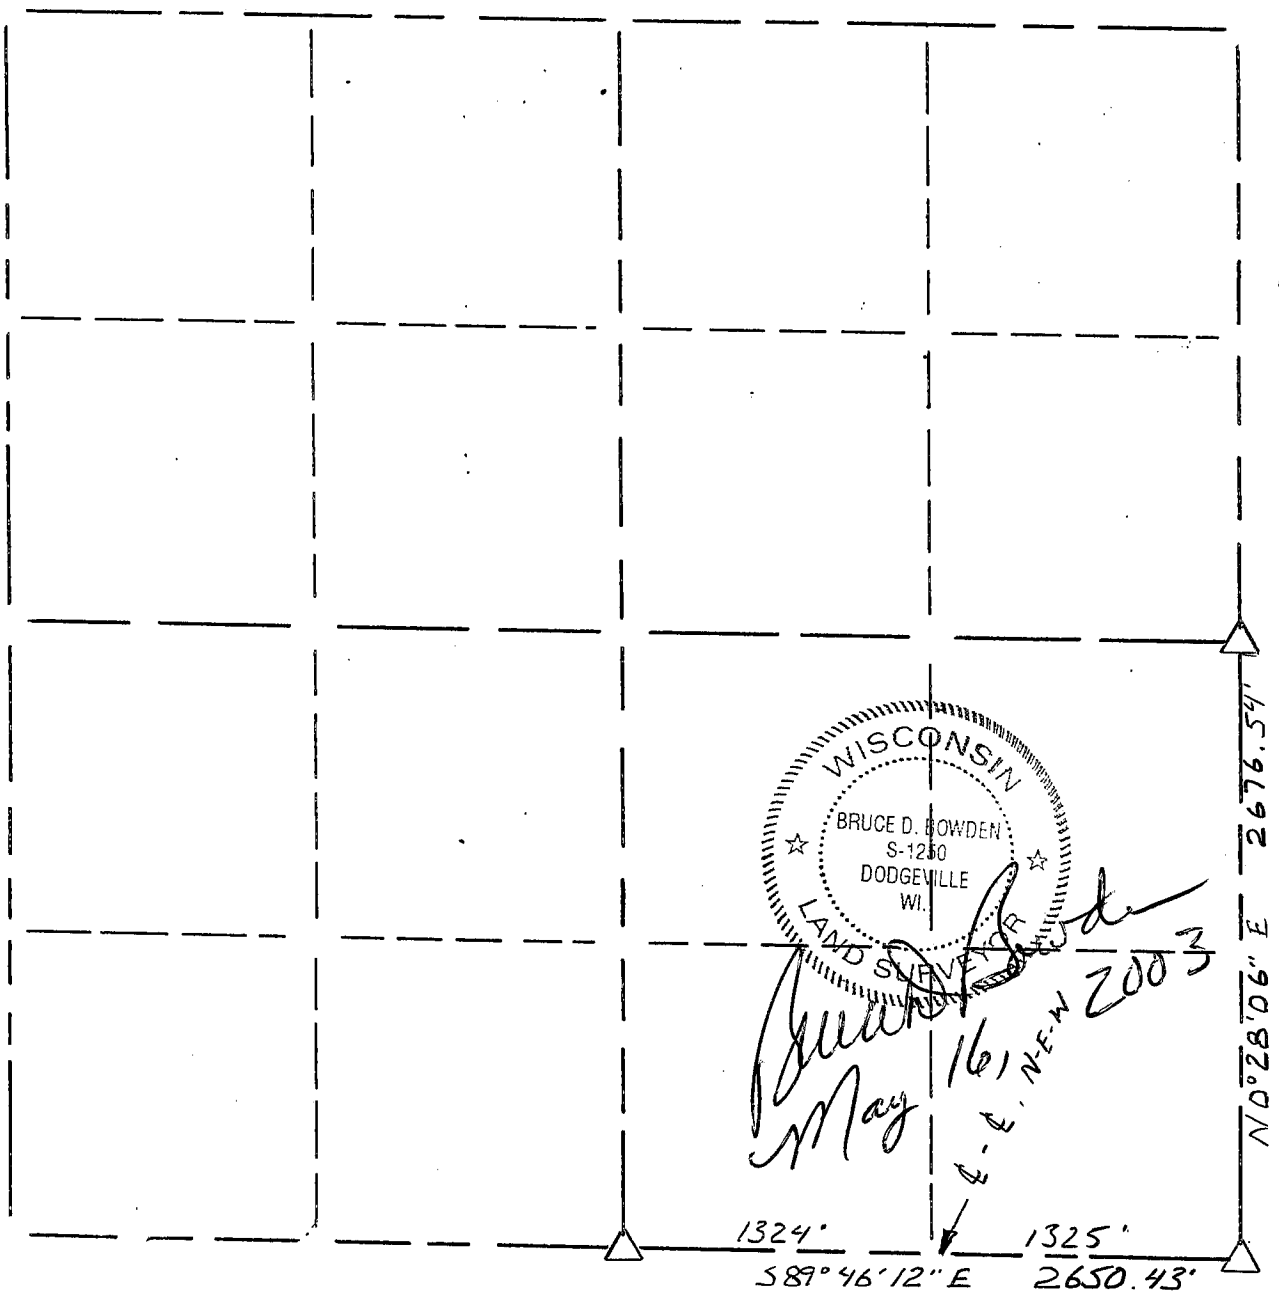

LEGEND

- △ COUNTY MONUMENT - SET
- STONE OR CONCRETE MONUMENT
- OTHER (specify) _____
- _____
- _____
- _____

NOTE:

Relationships of all section corners to other section corners shall be shown hereon by bearing and distance or grid coordinates

Show or describe bearing reference
 BEARINGS REFERENCED TO
 SOUTH LINE, SE 1/4, S 27, T 5N, R 1W,
 AS DEFINED BY THE GRANT CO.
 COORDINATE SYSTEM DETERMINED BY
 BY GPS OBSERVATION.