


# SECTION CORNER TIE SHEET INDEX

T. 5 N., R. 2 W

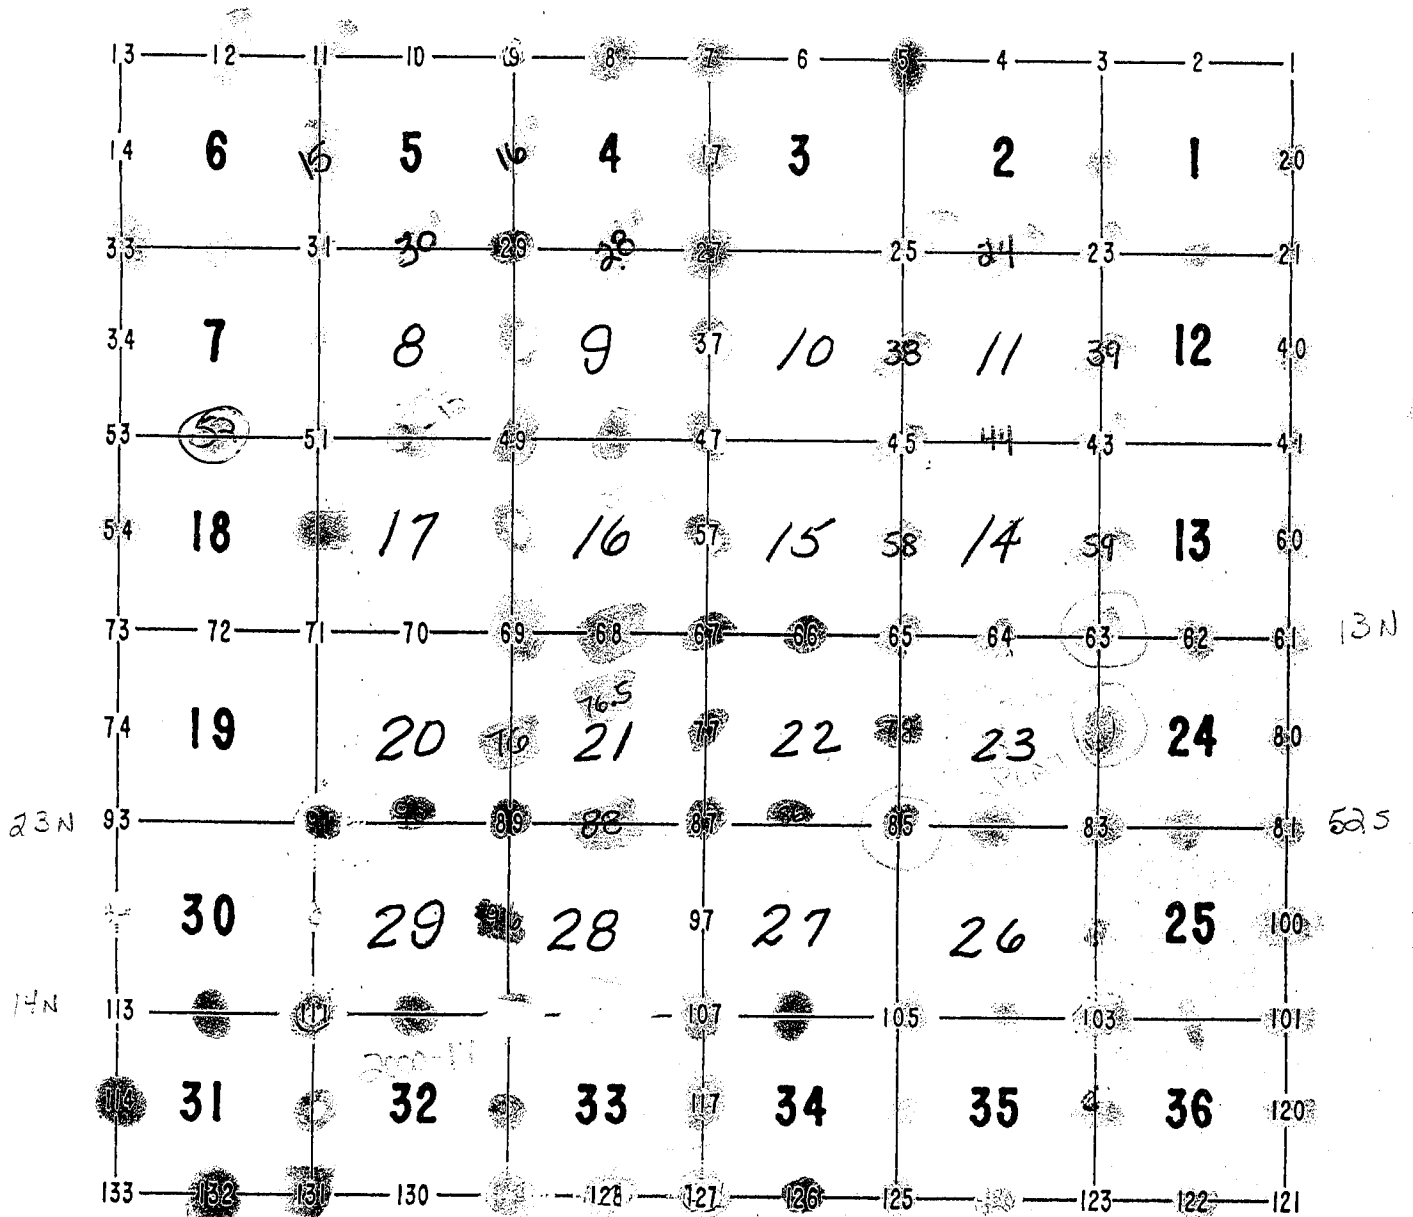

92-1-06

111 PAINT  
16 PAINT

55