

# U.S. PUBLIC LAND SURVEY MONUMENT RECORD - GRANT COUNTY, WI

Section 1, Town 5 North Range 2 West, Town of Liberty (a)


NOTE: This form is intended and designed to fulfill all requirements of the Wisconsin Administrative Code Chapter A-E 7.08, U.S. Public Land Survey Monument Record (3) (a) (b) (c) (d) (e) (f) (g) (h) (i).

**CERTIFICATE:** (i)

I, Aaron J. Austin, Wisconsin Professional Land Surveyor, do hereby certify that the corner location on this record was determined by me and/or under my direct supervision and that this U.S. Public Land Survey Monument Record is correct and complete to the best of my knowledge and belief.

Dated this 11th day of December, 2024.

*Aaron J. Austin*  
Aaron J. Austin, S-2922

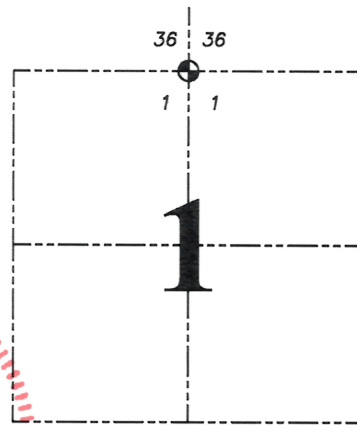

⊕ = CORNER LOCATION

Grant County Coordinates:  
NAD 83 (2011)  
Northing: 558,945.91  
Easting: 860,255.65

HISTORY OF CORNER ESTABLISHMENT:

Herbert Goold prepared a survey and retraced the South 1/4 of Section 36 for the North 1/4 of 1. Bruce Bowden set 1.25" Rebar with a Grant County Aluminum Cap and prepared a Survey Monument Record dated 6-24-1996. Larry Austin utilized this corner on a survey filed in Book 7 Page 1.

DESCRIPTION OF CORNER EVIDENCE FOUND: (b) (f) (g) (h)

The South 1/4 corner of Section 36 was accepted for the North 1/4 corner due to the survey by Herbert Goold dated 4-26-1890 filed in Book "D", Page 183 and a Survey by Larry Austin dated 12-10-1999 filed in Book 7, Page 1. On the survey filed in Book "D", Page 183, this corner was retraced from the roots of the original bearing trees. This corner was not set with the original government survey, therefore no bearing trees are referenced for the North 1/4 of Section 1 and it is believed that the corner was retraced for this survey was actually the South 1/4 corner of Section 36. I followed the footsteps of the previous surveyors to establish this corner's location. I accepted the 1.25" Rebar Bowden set. I found two witness corners and set two after I verified the Monument's location with G.P.S. and E.D.M. methods.

DESCRIPTION OF CORNER AND WITNESS MONUMENTS, references and accessories used to perpetuate the original or re-established location of this corner. (c) (d) (e)

Witnesses to corner location Shane Austin, Owen Austin, Tanner Austin.  
Drawn by: Owen Austin.

SKETCH:

## LEGEND

- ⊕ Section Corner—as designated
- 3/4" rebar found
- 3/4" x 18" rebar set
- ⊙ Wood post
- x-x- Existing fence

