

U.S. PUBLIC LAND SURVEY MONUMENT RECORD - GRANT COUNTY, WI

Section 18, Town 5 North Range 2 West, Town of Liberty (a)



NOTE: This form is intended and designed to fulfill all requirements of the Wisconsin Administrative Code Chapter A-E 7.08, U.S. Public Land Survey Monument Record (3) (a) (b) (c) (d) (e) (f) (g) (h) (i).

CERTIFICATE: (i)

I, Aaron J. Austin, Wisconsin Professional Land Surveyor, do hereby certify that the corner location on this record was determined by me and/or under my direct supervision and that this U.S. Public Land Survey Monument Record is correct and complete to the best of my knowledge and belief.

Dated this 12th day of November, 2016

Aaron J. Austin
 Aaron J. Austin, S-2922

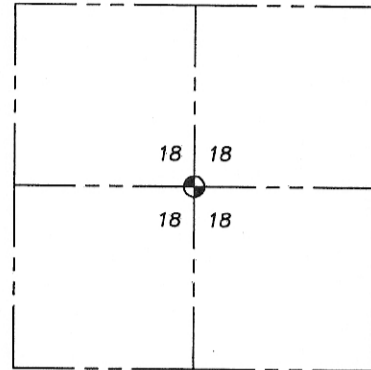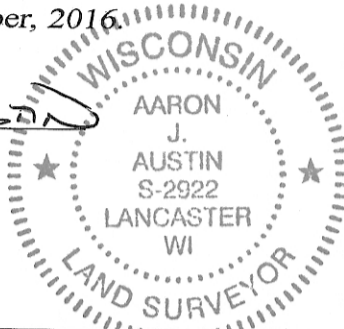

⊕ = CORNER LOCATION

Grant County Coordinates:

NAD 83 (2011)
 Northing: 545,599.39
 Easting: 833,684.97

HISTORY OF CORNER ESTABLISHMENT:

Corner was not set with original survey. Larry Austin set the corner on Certified Survey Map No. 965. I tied to the corner on a Survey dated 3-14-2012 filed in Book 34, Page 21.

DESCRIPTION OF CORNER EVIDENCE FOUND: (b) (f) (g) (h)

I found the 3/4" rebar as set by Larry Austin. I set 4 witness corners after I verified it's location with G.P.S. and E.D.M. methods. County Coordinates were established using WISCORS and G.P.S. Observations.

DESCRIPTION OF CORNER AND WITNESS MONUMENTS, references and accessories used to perpetuate the original or re-established location of this corner. (c) (d) (e)
 Witnesses to corner location Shane Austin.

