

# GRANT COUNTY CERTIFIED LAND CORNER


CORNER NO. 61

**CERTIFICATE:**

I, LARRY L. AUSTIN, DO HEREBY CERTIFY THAT ON NINETEENTH DAY OF MARCH, 1999, I FOUND EVIDENCE OF THE SOUTHEAST CORNER OF SECTION 13, TOWN 5 NORTH, RANGE 2 WEST, OF THE FOURTH PRINCIPAL MERIDIAN, AND I RE-ESTABLISHED SAID CORNER ACCORDING TO THE WISCONSIN STATUTES AS SHOWN AND DESCRIBED HEREON.

DATED THIS NINTH DAY OF APRIL, 1999

*Larry L. Austin*  
LARRY L. AUSTIN S-1903

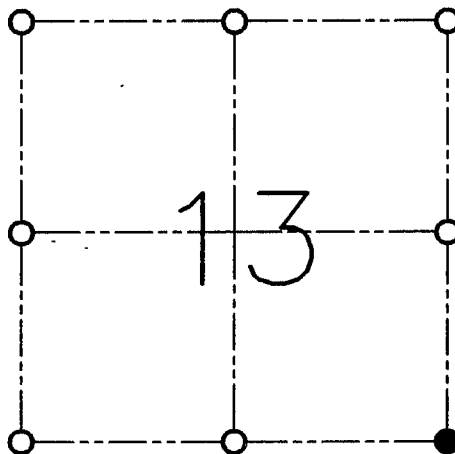

● = CORNER LOCATION

**SOUTHEAST CORNER SECTION 13  
T 5 N R 2 W  
TOWN OF LIBERTY**

**HISTORY OF ORIGINAL CORNER ESTABLISHMENT:**

CORNER WAS SET IN 1832 BY SIBLEY.

**DESCRIPTION OF CORNER EVIDENCE FOUND:**


I RESET THE CORNER BASED ON A TIE SHEET I FILED. (DATED 1997)  
VERIFIED THIS LOCATION USING E.D.M. AND G.P.S. METHODS.

**DESCRIPTION OF CORNER AND WITNESS MONUMENTS, REFERENCES AND ACCESSORIES USED TO PERPETUATE THE ORIGINAL OR RE-ESTABLISHED LOCATION OF THIS CORNER:**

**WITNESS TO THE CORNER LOCATION:**


BOBBY SEDGWICK  
SHELBY BLINDERT

**SKETCH:**

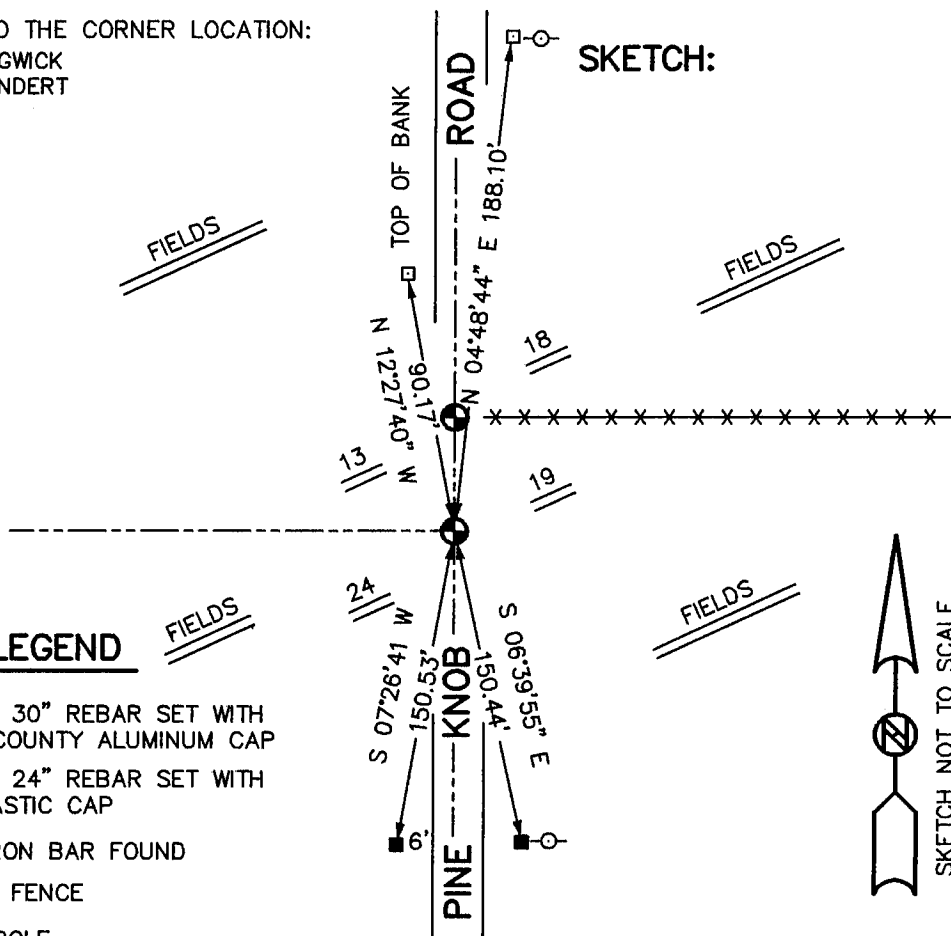

**LEGEND**

- NO. 8 X 30" REBAR SET WITH GRANT COUNTY ALUMINUM CAP
- NO. 4 X 24" REBAR SET WITH RED PLASTIC CAP
- NO. 4 IRON BAR FOUND
- \*—\*— EXISTING FENCE
- UTILITY POLE

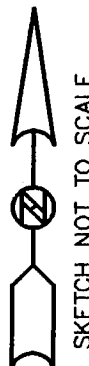


Survey Monument Record

TYPE OF MONUMENT RAILROAD SPIKE SET  
3" BELOW SURFACE

CORNER NO. 61  
 SECTION 24  
 TOWN 5N  
 RANGE 2W

FIELD BOOK: 96-21  
 PAGE (6)

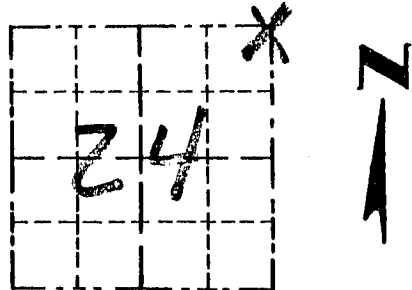


LOCATION  
 (Indicated by "X")

BASIS FOR MONUMENT LOCATION

(Use reverse side if necessary)

Show info such as: History of corner, with reference to Vol. and pg., dates, surveyor; exact description of monument replaced; if location computed, by taped or EDM traverse; landowner, remarks, etc.

SEAL:

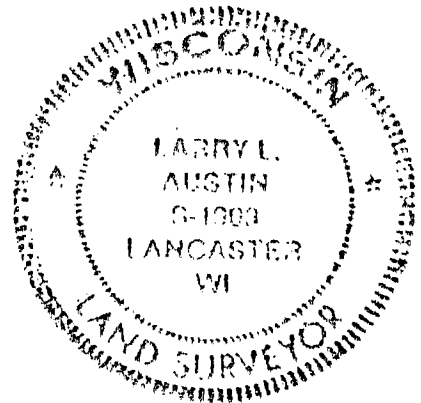

CORNER SET IN 1832 BY SIBLEY,  
 NO RECORD OF CORNER FOUND  
 SINCE ORIGINAL SURVEY. CORNER  
 SET AT THE RECORDED OFFSET  
 FROM A EXISTING FENCE EAST.  
 ACCEPTED ITS LOCATION AFTER  
 A EDM TRAVERSE OF AREA.

CERTIFIED CORRECT

*Larry L. Austin*  
 Registered Land Surveyor

DATE: \_\_\_\_\_

TIE SKETCH

Show at least three (3) ties and monument

LEGEND

- ▲ RAILROAD SPIKE SET
- 1/2" X 15" IRON BAR SET
- POWER POLE
- XX EXISTING FENCE

