


Survey Monument Record

CORNER NO. 81
 SECTION 24
 TOWN 5N
 RANGE 2W

TYPE OF MONUMENT RAILROAD SPIKE SET

FIELD BOOK: 96-21
 PAGE (6)

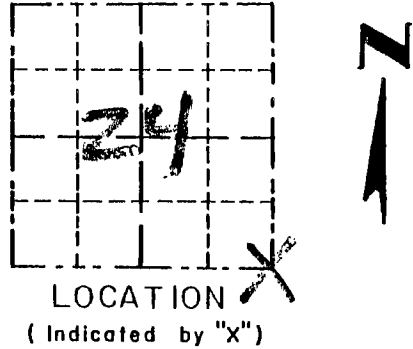

LOCATION (Indicated by "X")


BASIS FOR MONUMENT LOCATION

(Use reverse side if necessary)

Show info such as: History of corner, with reference to Vol. and pg., dates, surveyor; exact description of monument replaced; if location computed, by taped or EDM traverse; landowner, remarks, etc.

SEAL:

CORNER SET IN 1832 BY SIBLEY.
 IN BOOK B Page 555 FOUND
 RECORD OF JOEL BARBER LOCATING
 THE CORNER; BEARING TREES HE USED
 WERE UNRECOVERABLE. I ACCEPTED A
 NORTH/SOUTH ROAD FOR EASTING.
 NORTHING WAS SET AT THE RECORDED
 OFFSET FROM AN EXISTING FENCE
 TO THE EAST. VERIFIED ITS LOCATION
 USING EDM METHODS,

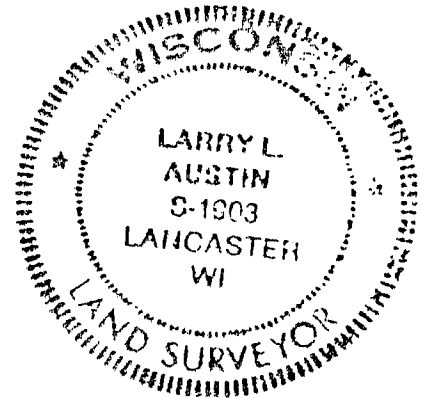

CERTIFIED CORRECT

Larry L. Austin
 Registered Land Surveyor

DATE: 2/16/97

TIE SKETCH

Show at least three (3) ties and monument

