

GRANT COUNTY

Survey Monument Record

CORNER NO. 101
 SECTION 36
 TOWN 5N
 RANGE 2W

TYPE OF MONUMENT 3/4" X 24" IRON BAR SET


STATE PLANE COORDINATES: N _____
 E _____

ELEVATION — M.S.L. DATUM: _____

THETA ANGLE: _____

FIELD BOOK: 96-08

PAGE _____

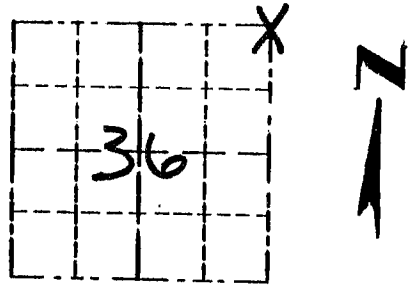


LOCATION
(Indicated by "X")

BASIS FOR MONUMENT LOCATION

(Use reverse side if necessary)

CORNER SET IN 1832 BY
 SIBLEY, ORIGINAL BEARING
 TREES WERE UNRECOVERABLE.
 CORNER WAS SET AT A
 OCCUPATIONAL FENCE CORNER.
 VERIFIED ITS LOCATION
 USING EDM METHODS.

SEAL:

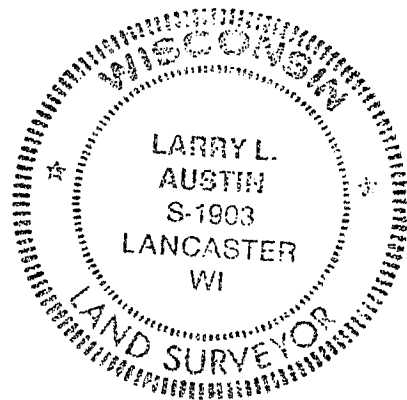

CERTIFIED CORRECT

Larry L. Austin
 Registered Land Surveyor

DATE: 10-1-96

TIE SKETCH

Show at least three (3) ties and monument

LEGEND

⊕ 3/4" X 24" IRON BAR SET

□ 2" IRON PIPE FOUND

○ 1/2" X 18" IRON BAR SET

XX EXISTING FENCE

