


Survey Monument Record

CORNER NO. 107
SECTION 34
TOWN 5N
RANGE 2W
NW COR.

TYPE OF MONUMENT COUNTY MONUMENT
STATE PLANE COORDINATES: N _____
E _____
ELEVATION — M.S.L. DATUM: _____
THETA ANGLE: _____
FIELD BOOK: _____
PAGE _____

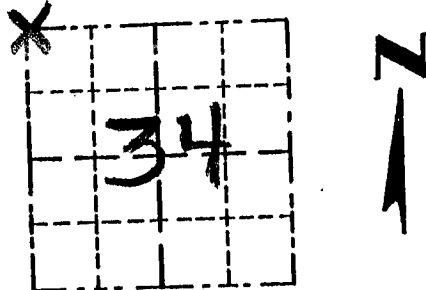

LOCATION
(Indicated by "X")


BASIS FOR MONUMENT LOCATION

(Use reverse side if necessary)

Show info such as: History of corner, with reference to Vol. and pg., dates, surveyor; exact description of monument replaced; if location computed, by taped or EDM traverse; landowner, remarks, etc.

SEAL:

ORIGINAL CORNER SET IN 1932
BY HARVEY PARKE; NO
RECORD FOUND OF CORNER SINCE
ORIGINAL SURVEYS; I SET THE
CORNER AT OCCUPIED LOCATION
& VERIFIED BY EDM TRAVERSE
OF THE AREA;

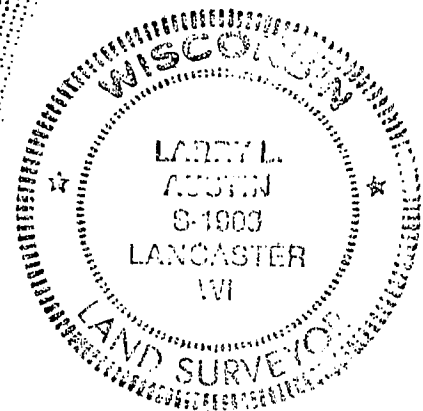

CERTIFIED CORRECT

Larry L. Austin
Registered Land Surveyor

DATE: 2/16/95

TIE SKETCH

Show at least three (3) ties and monument

