

GRANT COUNTY

Survey Monument Record

TYPE OF MONUMENT 3/4" X 24" IRON BAR

STATE PLANE COORDINATES: N FOUND
E _____

ELEVATION - M.S.L. DATUM: _____

THETA ANGLE: _____

FIELD BOOK: 96-08


PAGE _____

CORNER NO. 120

SECTION 36

TOWN 5N

RANGE 2W

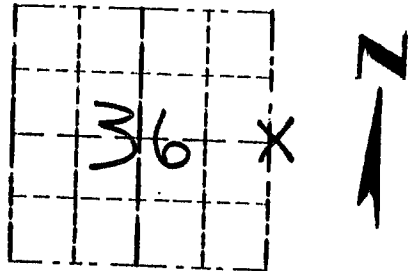

LOCATION
(Indicated by "X")


BASIS FOR MONUMENT LOCATION

(Use reverse side if necessary)

CORNER SET IN 1832 BY
SIBLEY, IN 1989 DOUGLAS
MALLIET SET THE WEST SEAL:

1/4 CORNER SECTION 31 TSNRIW.

I ACCEPTED HIS CORNER
AS THE EAST 1/4 CORNER
SECTION 36 TSNRZW, CORNER
IS SET ON LINE WITH FENCE
WEST AND CENTER LINE NORTH/
SOUTH, VERIFIED ITS LOCATION
USING EDM METHODS.

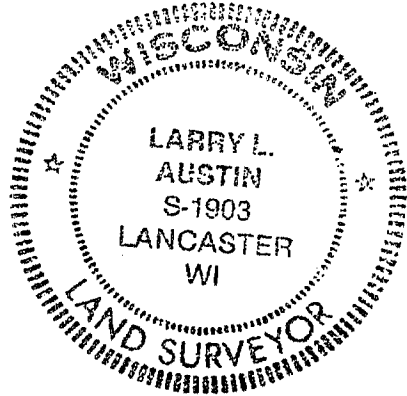

CERTIFIED CORRECT

Larry L. Austin
Registered Land Surveyor

DATE: 10-1-96

TIE SKETCH

Show at least three (3) ties and monument

