

# GRANT COUNTY

## Survey Monument Record

TYPE OF MONUMENT COUNTY ALUMINUM MON.

STATE PLANE COORDINATES: N \_\_\_\_\_  
E \_\_\_\_\_


ELEVATION — M.S.L. DATUM: \_\_\_\_\_

THETA ANGLE: \_\_\_\_\_

FIELD BOOK: \_\_\_\_\_

PAGE \_\_\_\_\_

CORNER NO. 9  
SECTION 32  
TOWN 5 N  
RANGE 2 W

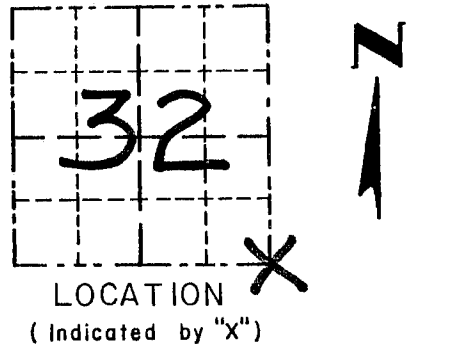


### BASIS FOR MONUMENT LOCATION

(Use reverse side if necessary)

CORNER WAS SET AT AN EAST-WEST FENCE FOR NORTH-SOUTH LOCATION AND AT THE RECORDED DISTANCE OF 57 LINKS EAST OF THE NORTHEAST CORNER OF SECTION 5 AND VERIFIED BY EDM TRAVERSE OF THE AREA.

SEAL:

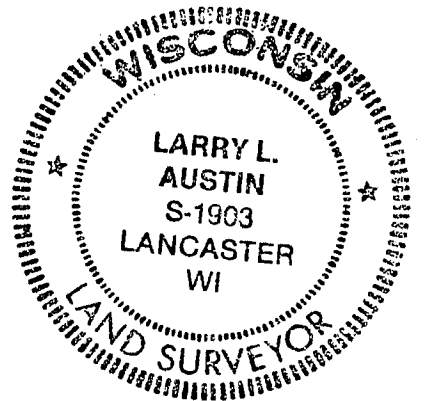

CERTIFIED CORRECT

*Larry L. Austin*  
Registered Land Surveyor

DATE: 12/5/95

### TIE SKETCH

Show at least three (3) ties and monument

### LEGEND

- ⊕ GRANT COUNTY ALUMINUM MONUMENT
- ▲ 1/2" REBAR

