


U.S. PUBLIC LAND SURVEY MONUMENT RECORD – GRANT COUNTY, WI

Summary of Section 8, Town 5 North, Range 2 West, Town of Liberty

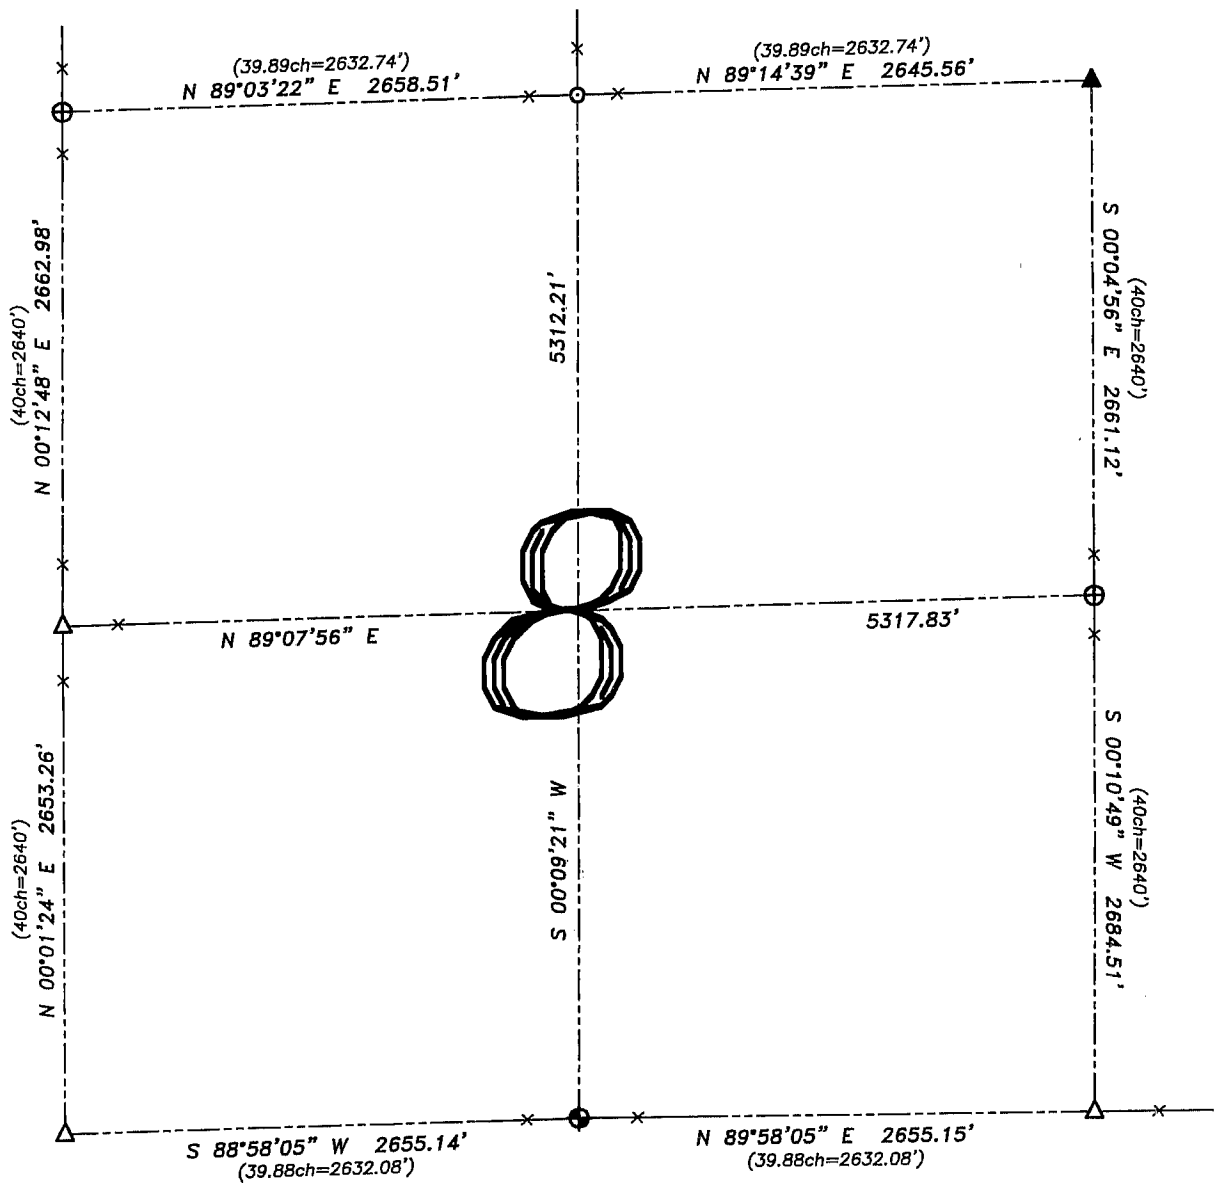


LEGEND

- ⊕ No. 8 rebar found with Grant County Aluminum Cap
- ⊕ No. 8 x 30" rebar set with Grant County Aluminum Cap – wt=2.67#/l.f.
- ⊙ No. 6 rebar found
- △ 1" diameter iron pipe found
- ▲ 2" diameter iron pipe found
- x— Approximate location of fence

Relationship of all section corners to other section corners shall be shown hereon by bearing and distance or grid coordinates. Bearing reference shown below.

Dated this 12th day of July, 2005

Larry L. Austin
Larry L. Austin S-1903

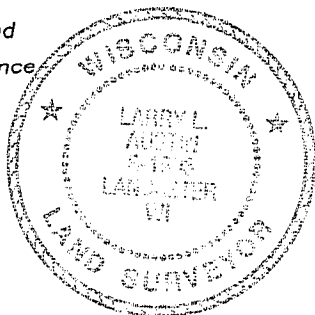

BEARINGS REFERENCED TO THE NORTH LINE OF THE NORTHEAST QUARTER OF SECTION 8, WHICH IS ASSUMED TO BEAR N 89°14'39" E.

SKETCH NOT TO SCALE



Austin
Engineering LLC

4211 HWY 81 E, LANCASTER, WI 53813
PHONE 608-723-6363 FAX 608-723-6702

JOB NUMBER: 05S160
FIELDBOOK: TDSR, 2217
G:\T5NR2W\09
H:\TIE\T5NR2W\08SUM

DRAWN BY: SW AUSTIN
APPROVED: LL AUSTIN