


U.S. PUBLIC LAND SURVEY MONUMENT RECORD – GRANT COUNTY, WI

Summary of Section 18, Town 5 North, Range 2 West, Town of Liberty

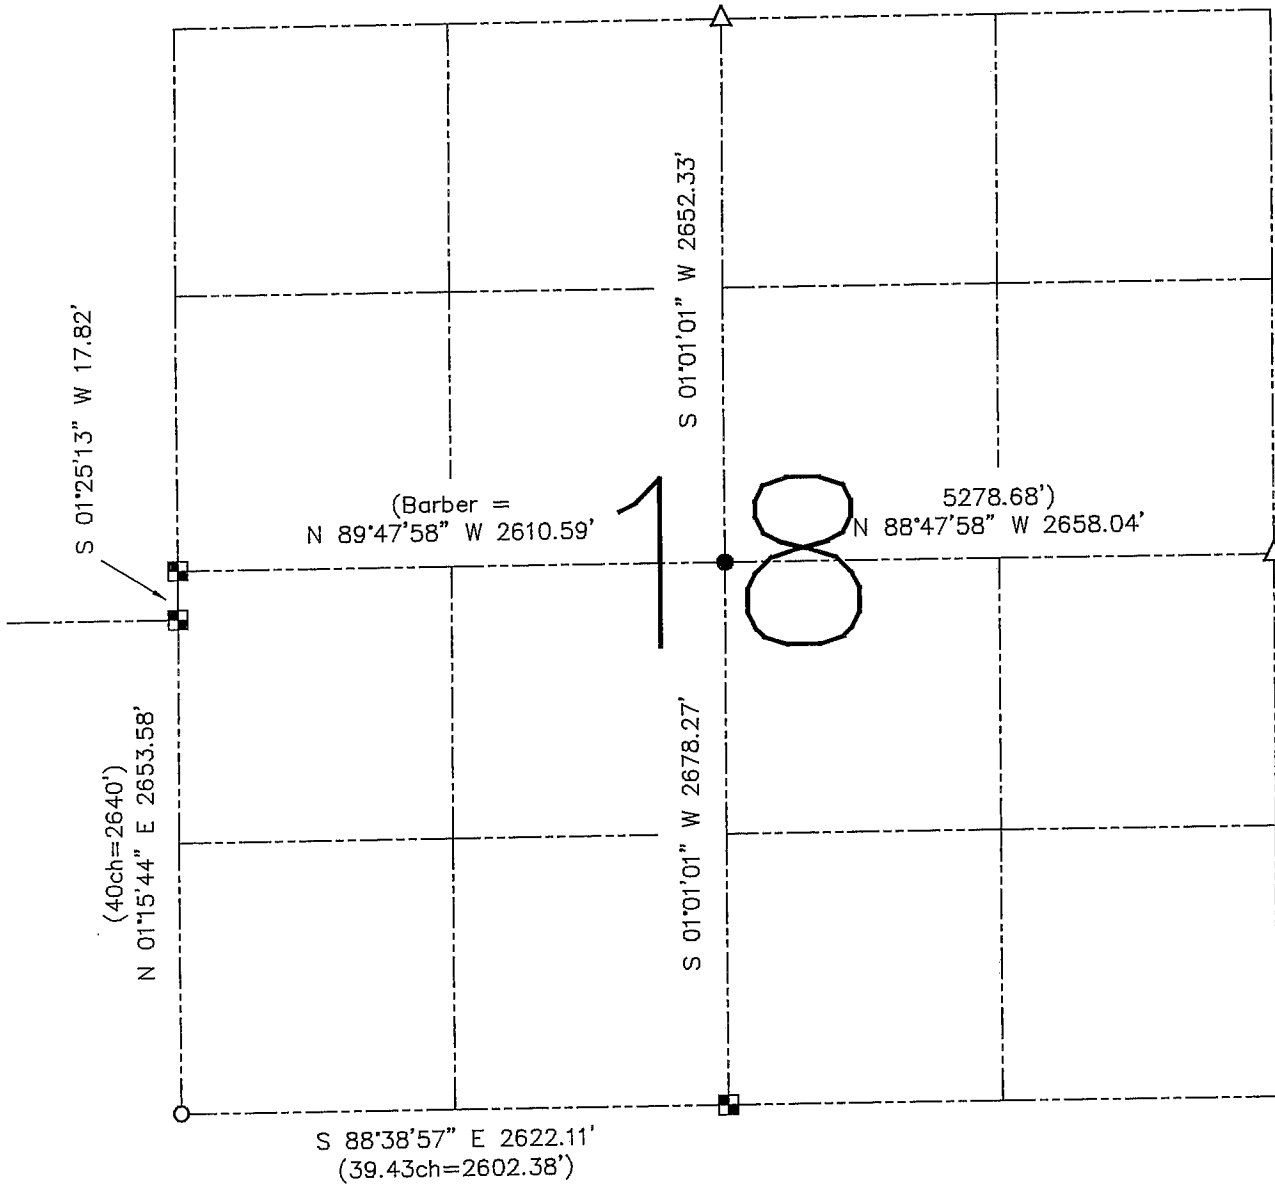


LEGEND

- △ 1" diameter iron pipe found
- No. 6 rebar found
- No. 6 x 24" rebar set with cap – wt=1.50 #/l.f.
- Aluminum Monument found with Grant County Aluminum Cap
- () Recorded as
- x— Approximate location of existing fence

Relationship of all section corners to other section corners shall be shown hereon by bearing and distance or grid coordinates. Bearing reference shown below.

Dated this 27th day of May, 2003

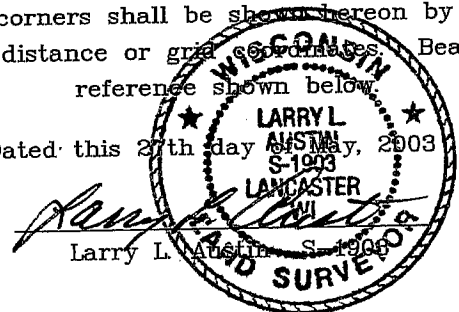

Bearings referenced to the South line of the Southwest Quarter of this Section, which is assumed to bear S 88° 38' 57" E.

SKETCH NOT TO SCALE

AUSTIN ENGINEERING, LLC
 4211 HWY 81 EAST, LANCASTER, WI 53813
 PHONE 608-723-6363 FAX 608-723-6702

FIELDBOOK: TDS RNGR, 94-00
 G: \T5NR2W\19
 H: \TIE\T5NR2W\18SUM

CREW: BS-SB-SA-BD
 DRAWN BY: SW AUSTIN
 APPROVED: LL AUSTIN