


U.S. PUBLIC LAND SURVEY MONUMENT RECORD

Section 2, Town 5 North Range 3 West, Town of
North Lancaster, Grant County, Wisconsin

CERTIFICATE

I, Larry L. Austin, do hereby
certify that the corner location
on this record was determined by
me and/or under my direct
supervision and that this U.S.
public land survey monument record
is correct and complete to the best
of my knowledge and belief.

Larry L. Austin
Larry L. Austin, S-1903

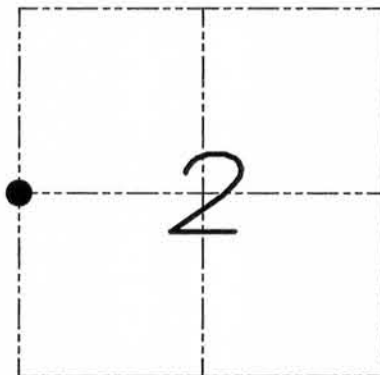

● = CORNER LOCATION

HISTORY OF CORNER

Corner was originally set in 1833 by Harvey Parke.
No other record of the corner was found.

CORNER EVIDENCE FOUND


I reset the corner at an occupied location of a split in fence North-South and verified this
location by using EDM and GPS methods.

DESCRIPTION OF CORNER AND WITNESS MONUMENTS, references and accessories used to
perpetuate the original or re-established location of this corner. Witnesses to monument
location Bobby Sedgwick & Brad Digman & Shane Austin

SKETCH:

LEGEND

- Number 8 x 30" rebar set with Grant County Aluminum cap
- Number 4 x 24" Rebar set with red plastic "TIE" cap
- x— Approximate existing fence

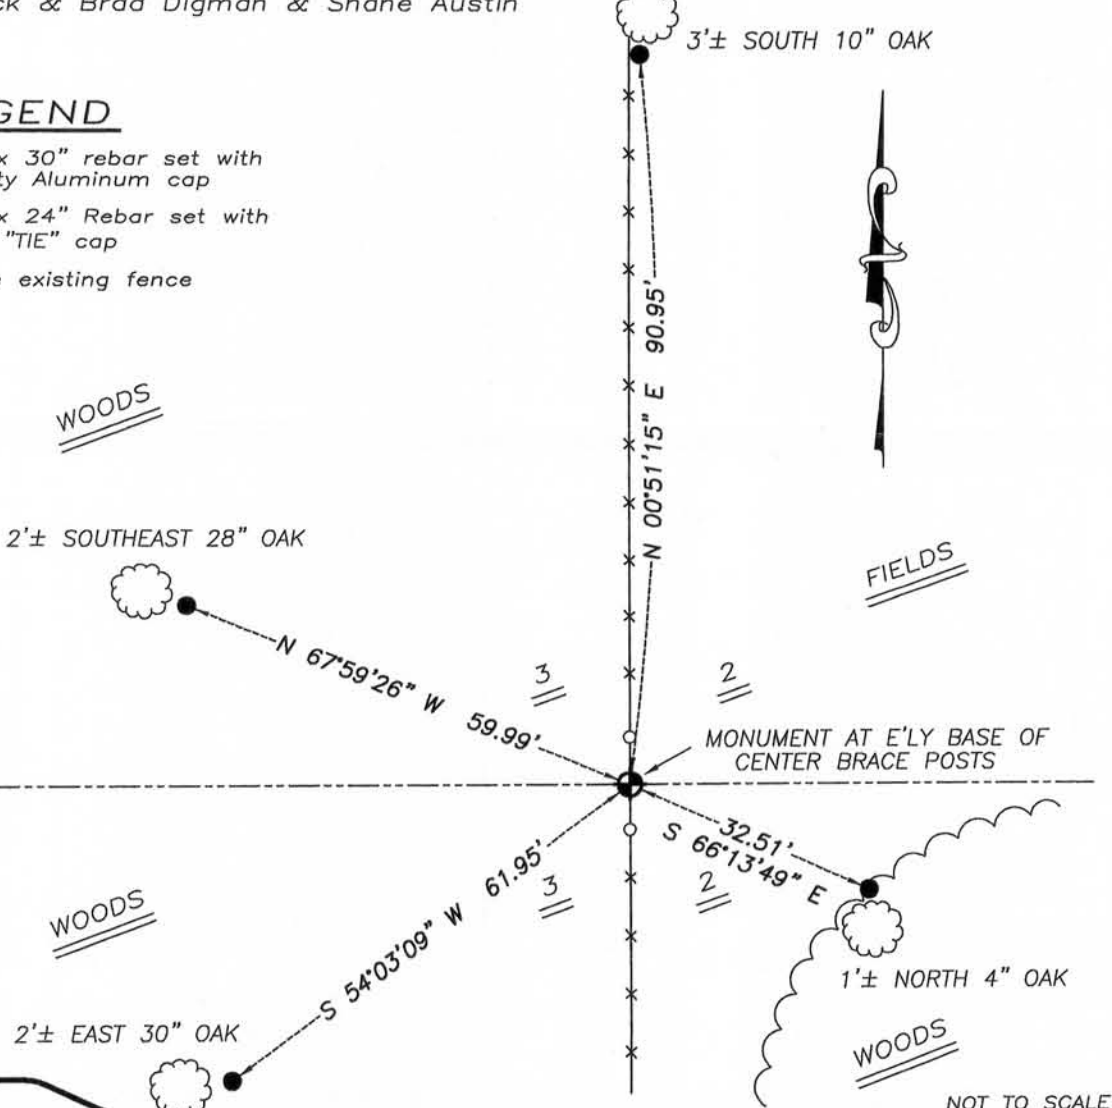

NOT TO SCALE



Austin
Engineering LLC

4211 HWY 81 E, LANCASTER, WI 53813
PHONE 608-723-6363 FAX 608-723-6702

JOB NUMBER 09S022-OSTER
FIELDBOOK: TDSR, 2802
G:\T5NR3W\02
H:\TIE\T5NR3W\18

DRAWN BY: SW AUSTIN
APPROVED: LL AUSTIN

18

DEC 14 2011