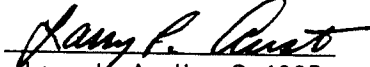




U.S. PUBLIC LAND SURVEY MONUMENT RECORD - GRANT COUNTY, WI
Section 7, Town 5 North Range 3 West, Town of North Lancaster

CERTIFICATE

I, Larry L. Austin, do hereby certify that the corner location on this record was determined by me and/or under my direct supervision and that this U.S. public land survey monument record is correct and complete to the best of my knowledge and belief.

Dated this 16th day of January, 2002


Larry L. Austin S-1903

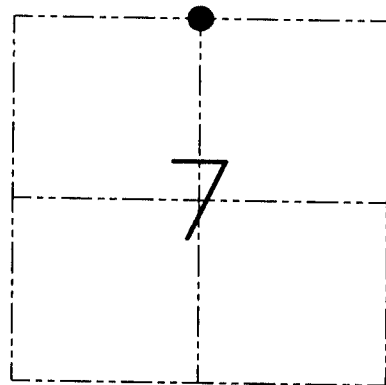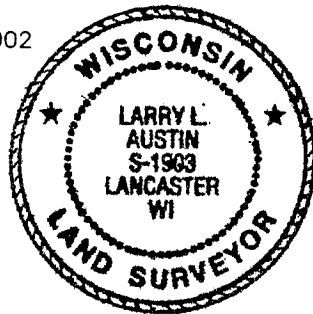

● = CORNER LOCATION

HISTORY OF CORNER ESTABLISHMENT


Corner was originally set in 1833 by Harvey Parke. In 1882 J.C. Scott found a stone pile and accepted it. In 1987 Malliet established the corner proportionately on the North line of Section 7, with no mention of monument.

DESCRIPTION OF CORNER EVIDENCE FOUND

I found this stone pile and accepted it's location. This location fit other corners in the Section. Verified it's location after an EDM & GPS traverse of the area.

DESCRIPTION OF CORNER AND WITNESS MONUMENTS, references and accessories used to perpetuate the original or re-established location of this corner. Witnesses to the corner location Bobby Sedgwick & Shelby Blindert & Kelly Wolf

SKETCH:

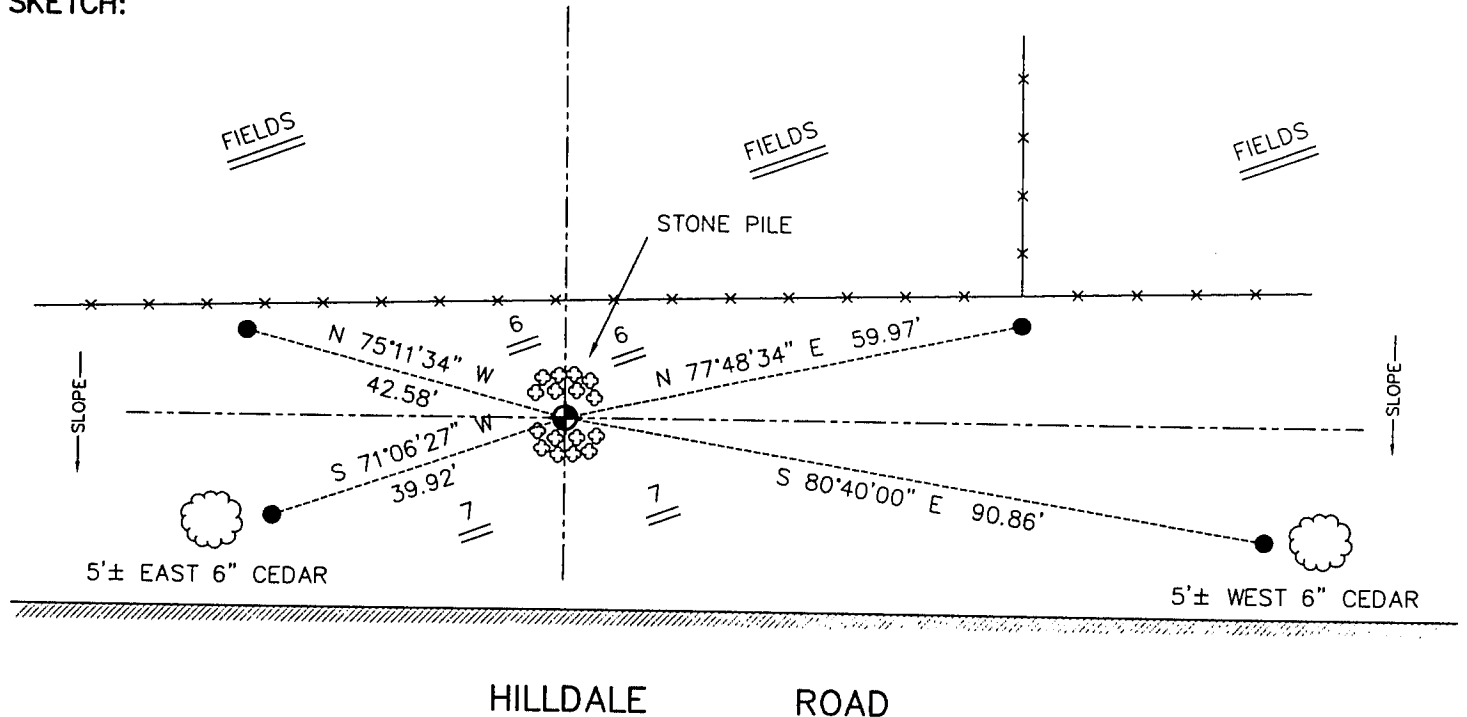

LEGEND

-  Number 8 x 30" rebar set with Grant County Aluminum Cap
-  Number 4 x 24" Rebar set with red plastic "TIE" cap
-  Approximate existing fence



* SEE SECTION SUMMARY FOR *
RELATIONSHIP TO AREA CORNERS

SKETCH NOT TO SCALE

AUSTIN ENGINEERING, LLC

4211 HWY 81 EAST, LANCASTER, WI 53813
PHONE 608-723-6363 FAX 608-723-6702

FIELDBOOK: SDR33, 2151

G: \T5NR3W\08

C: \SWA\TIE\T5NR3W\32

CREW: BS-SB-SA-KW

DRAWN BY: SW AUSTIN

APPROVED: LL AUSTIN

CORNER NUMBER 32