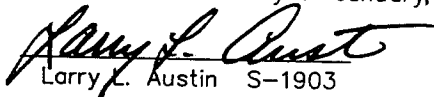




U.S. PUBLIC LAND SURVEY MONUMENT RECORD - GRANT COUNTY, WI
Section 7, Town 5 North Range 3 West, Town of North Lancaster

CERTIFICATE

I, Larry L. Austin, do hereby certify that the corner location on this record was determined by me and/or under my direct supervision and that this U.S. public land survey monument record is correct and complete to the best of my knowledge and belief.

Dated this 16th day of January, 2002


Larry L. Austin S-1903

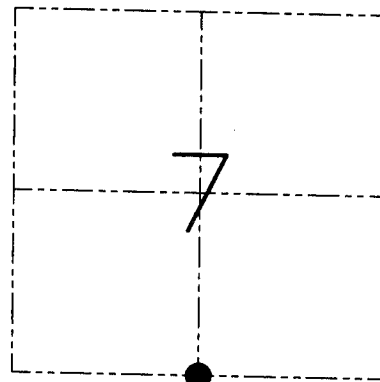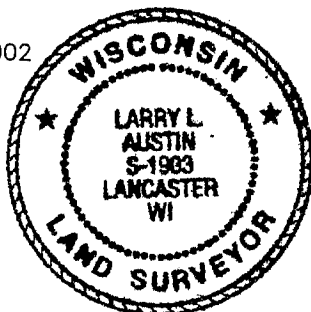

● = CORNER LOCATION

HISTORY OF CORNER ESTABLISHMENT


Corner was originally set in 1833 by Parke. In 1995 I set the corner.

DESCRIPTION OF CORNER EVIDENCE FOUND

I found the corner to be inaccurately set by myself. I reset the corner proportionately. Bulldozing was done in the area so some ties had to be placed. Verified this location using EDM & GPS methods.

DESCRIPTION OF CORNER AND WITNESS MONUMENTS, references and accessories used to perpetuate the original or re-established location of this corner. Witnesses to the corner location Bobby Sedgwick & Shelby Blindert & Brad Digman

SKETCH:

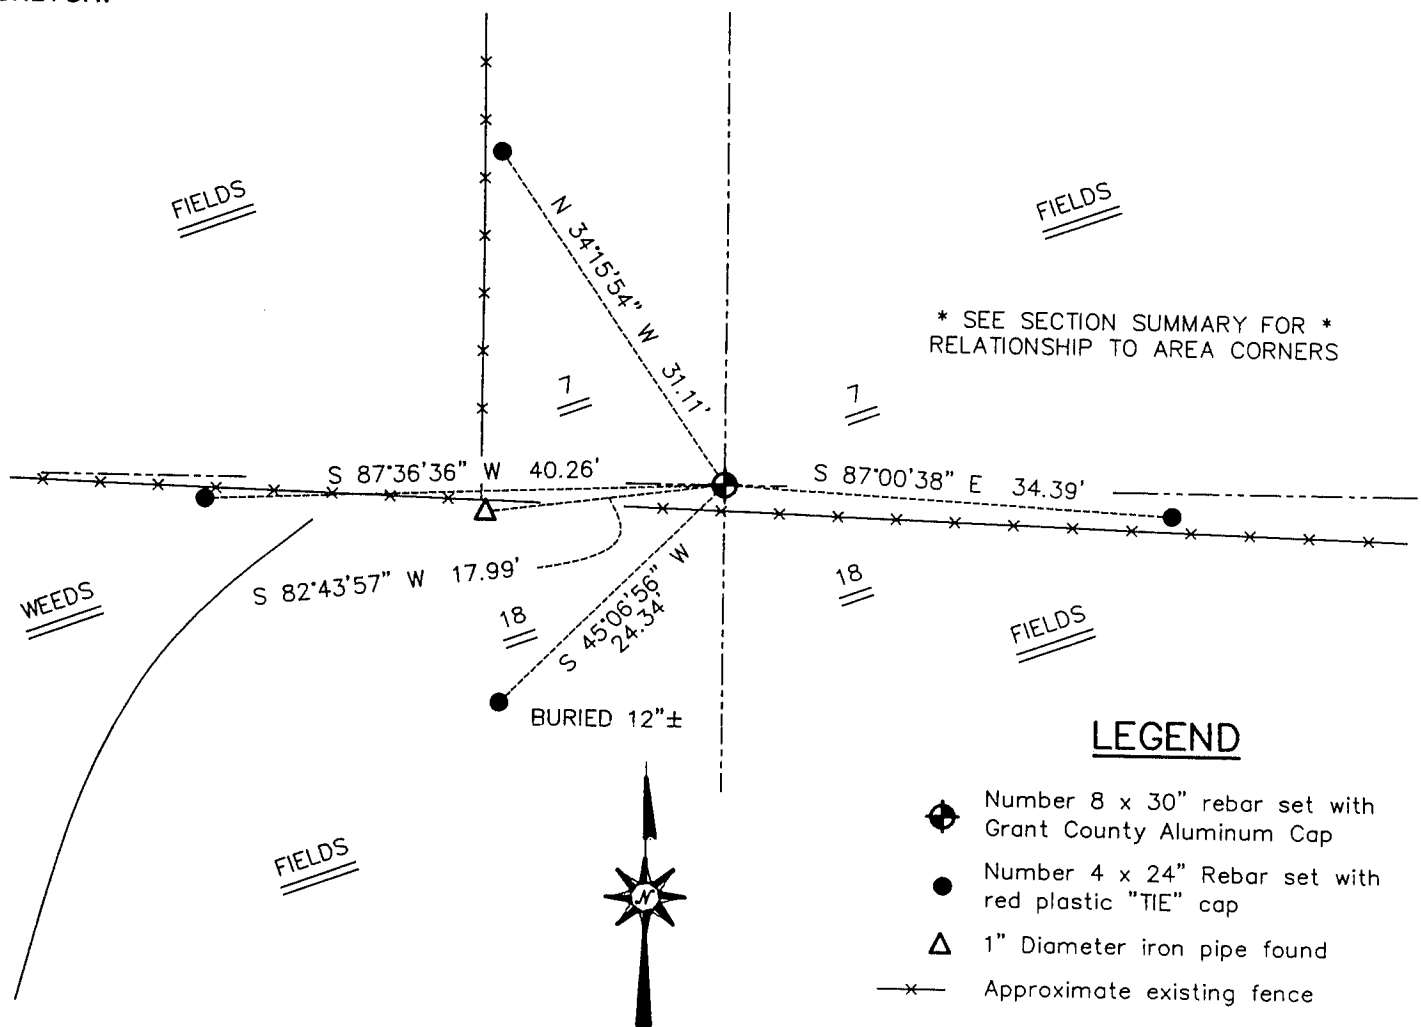

AUSTIN ENGINEERING, LLC

4211 HWY 81 EAST, LANCASTER, WI 53813
PHONE 608-723-6363 FAX 608-723-6702

DRAWN BY: SW AUSTIN
APPROVED: LL AUSTIN

CORNER NUMBER 52

GRANT COUNTY

Survey Monument Record

TYPE OF MONUMENT COUNTY MONUMENT
STATE PLANE COORDINATES: N —
E —
ELEVATION — M.S.L. DATUM: —
THETA ANGLE: —
FIELD BOOK: 9505
PAGE 17

CORNER NO. 52
SECTION 18
TOWN 5 N
RANGE 3 W
N 1/4 COR.



LOCATION
(Indicated by "X")

BASIS FOR MONUMENT LOCATION

(Use reverse side if necessary)

Show info such as: History of corner, with reference to Vol. and pg., dates, surveyor; exact description of monument replaced; if location computed, by taped or EDM traverse; landowner, remarks, etc.

SEAL:

NO RECORD FOUND SINCE
ORIGINAL SURVEY IN 1833
BY PARKE. I SET THE CORNER
BY PROPORTIONING ITS E-W LOCATION
& ACCEPTING THE E-W FENCE FOR
THE N-S LOCATION; VERIFIED BY
EDM TRAVERSE OF THE AREA.

CERTIFIED CORRECT

Randy R. Aust
Registered Land Surveyor

DATE: 9/15/95

TIE SKETCH

Show at least three (3) ties and monument

LEGEND

- ⊙ GRANT COUNTY ALUMINUM MONUMENT SET
- 1" x 12" MIN IRON PIPE SET AS TIES
- *-* EXISTING FENCE

