


REC'D JUL 5 1996

Survey Monument Record

CORNER NO. 53  
SECTION 18  
TOWN 5N  
RANGE 3W

TYPE OF MONUMENT COUNTY MONUMENT SET  
STATE PLANE COORDINATES: N \_\_\_\_\_  
E \_\_\_\_\_

ELEVATION — M.S.L. DATUM: \_\_\_\_\_  
THETA ANGLE: \_\_\_\_\_  
FIELD BOOK: 95-16  
PAGE (5)

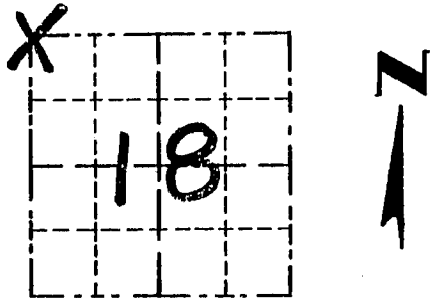


LOCATION  
(Indicated by "X")

BASIS FOR MONUMENT LOCATION

(Use reverse side if necessary)

- NO RECORD FOUND SINCE ORIGINAL SURVEY BY HARVEY PARKE IN 1833.
- CORNER RESET ON THE EAST LINE OF THE SE 1/4 OF SECTION 12, T5N, R4W AND AT THE RECORDED CLOSING CORNER DISTANCE OF 18 LINKS (11.88') FROM THE SE COR OF SAID SECTION 12.
- VERIFIED BY EDM TRAVERSE OF THE AREA.

SEAL:

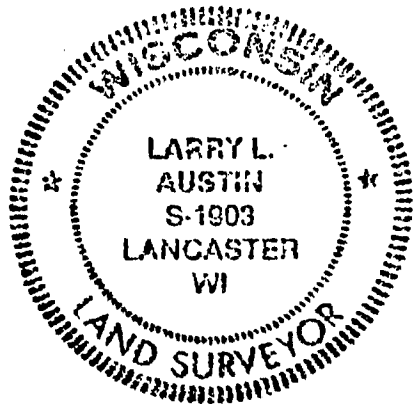

CERTIFIED CORRECT

*Larry L. Austin*  
Registered Land Surveyor

DATE: 3/5/96

TIE SKETCH

Show at least three (3) ties and monument

