

Survey Monument Record

CORNER NO. 54  
SECTION 18  
TOWN 5N  
RANGE 3W

TYPE OF MONUMENT COUNTY MONUMENT SET


STATE PLANE COORDINATES: N \_\_\_\_\_  
E \_\_\_\_\_

ELEVATION — M.S.L. DATUM: \_\_\_\_\_

THETA ANGLE: \_\_\_\_\_

FIELD BOOK: 95-16

PAGE (5)

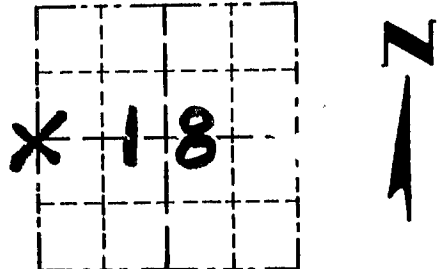


LOCATION  
(Indicated by "X")

BASIS FOR MONUMENT LOCATION

(Use reverse side if necessary)

THE CORNER WAS SET ON THE EAST LINE OF SEC 13 AT THE AVERAGE OF THE CLOSING CORNER DISTANCES AT THE NE CORNER & THE SE CORNER OF SECTION 13.

SEAL:

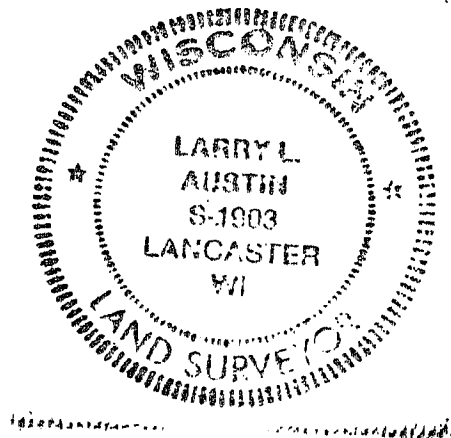

VERIFIED BY EDM TRAVERIE

CERTIFIED CORRECT

*Larry L. Austin*  
Registered Land Surveyor

DATE: 3-5-96

TIE SKETCH

Show at least three (3) ties and monument

LEGEND

- ⊕ COUNTY MONUMENT SET
- 1"X12" IRON PIPE SET
- XX EXISTING FENCE

