

GRANT COUNTY

Survey Monument Record

TYPE OF MONUMENT ALUMINUM MONUMENT

STATE PLANE COORDINATES: N _____
E _____

ELEVATION — M.S.L. DATUM: _____


THETA ANGLE: _____

FIELD BOOK: 9415

PAGE 21

CORNER NO. 55
SECTION 17
TOWN 5N
RANGE 3W

W 1/4 COR

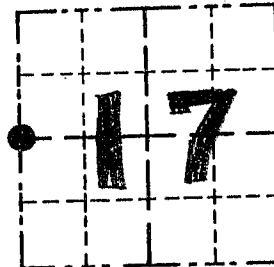

LOCATION
(Indicated by "•")


BASIS FOR MONUMENT LOCATION

(Use reverse side if necessary)

Show info such as: History of corner, with reference to Vol. and pg., dates, surveyor; exact description of monument replaced; if location computed, by taped or EDM traverse; landowner, remarks, etc.

SEAL:

NO RECORD OF CORNER FD,
SINCE ORIGINAL SURVEY; I
ACCEPTED OCCUPATION LOCATION
& VERIFIED BY EDM TRAVERSE
OF THE AREA.

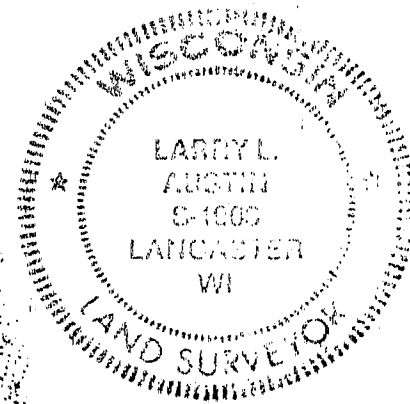

CERTIFIED CORRECT

Larry L. Austin
Registered Land Surveyor

DATE: 8/30/94

TIE SKETCH

Show at least three (3) ties and monument

