

Survey Monument Record

TYPE OF MONUMENT GRANT COUNTY

Alum. Mon. Found.


FIELD BOOK: 96-17
PAGE (5)

CORNER NO. 69
SECTION 21
TOWN 5N
RANGE 3W

BASIS FOR MONUMENT LOCATION

(Use reverse side if necessary)


Show info such as: History of corner, with reference to Vol. and pg., dates, surveyor; exact description of monument replaced; if location computed, by taped or EDM traverse; landowner, remarks, etc.

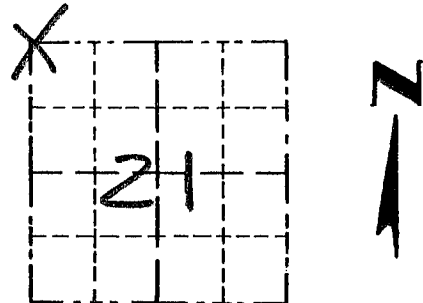

LOCATION
(Indicated by "X")

SEAL:

CORNER SET BY HARVEY CLARK, IN 1987. I SET AN ALUM. MON AT AN OCCUPIED FENCE CORNER. I ACCEPTED THIS LOCATION AFTER A EDM TRAVERSE OF AREA.

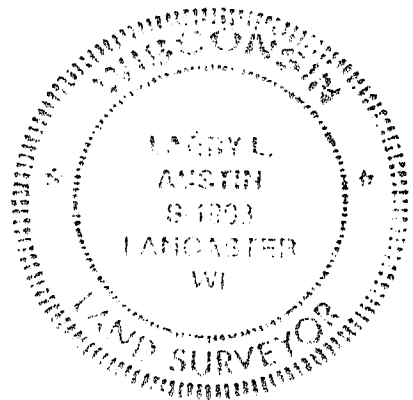

CERTIFIED CORRECT

Larry L. Austin
Registered Land Surveyor

DATE: 7-30-97

TIE SKETCH

Show at least three (3) ties and monument

LEGEND

- GRANT COUNTY ALUM. MON. FND. Woods
- 1/2" X 15" IRON BAR SET
- XX EXISTING FENCE

