

GRANT COUNTY

Survey Monument Record

TYPE OF MONUMENT ALUMINUM MONUMENT
 STATE PLANE COORDINATES: N _____
 E _____
 ELEVATION — M.S.L. DATUM: _____
 THETA ANGLE: _____
 FIELD BOOK: 94-15
 PAGE 21

CORNER NO. 70
 SECTION 17
 TOWN 5N
 RANGE 3W
S 1/4 COR



LOCATION
 (Indicated by "•")

BASIS FOR MONUMENT LOCATION

(Use reverse side if necessary)

Show info such as: History of corner, with reference to Vol. and pg., dates, surveyor; exact description of monument replaced; if location computed, by taped or EDM traverse; landowner, remarks, etc.

SEAL:

NO RECORD FOUND OF COR.
SINCE ORIG. SURVEYS; MONU-
MENT SET AT OCCUPIED LOCATION
& VERIFIED BY EDM TRAVERSE OF
THE AREA.



CERTIFIED CORRECT

Larry L. Austin
 Registered Land Surveyor


DATE: 8/30/94

TIE SKETCH

Show at least three (3) ties and monument

LEGEND

- ALUMINUM MONUMENT
- 1" x 12" IRON PIPE SET
- FENCE EXISTING

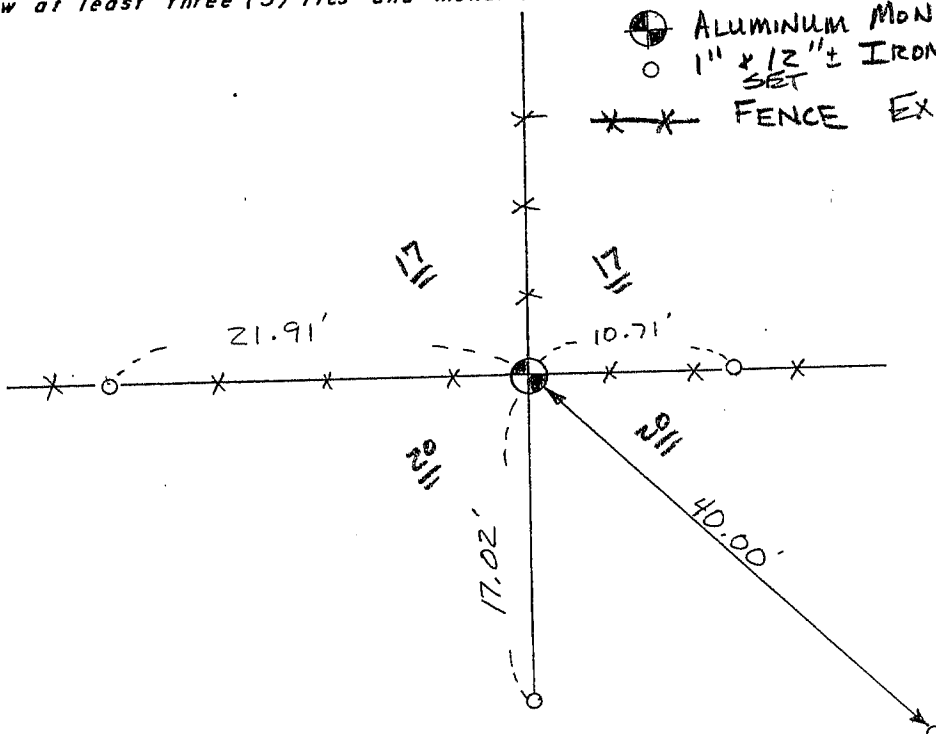

NO SCALE