

GRANT COUNTY

Survey Monument Record

TYPE OF MONUMENT GRANT Co. ALUMIN. MON.

STATE PLANE COORDINATES: N _____
E _____


ELEVATION — M.S.L. DATUM: _____

THETA ANGLE: _____

FIELD BOOK: 94-15

PAGE 22

CORNER NO. 71
SECTION 17
TOWN 5N
RANGE 3W
SW COR

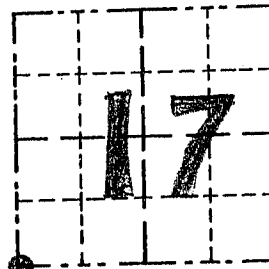

LOCATION
(Indicated by "●")


BASIS FOR MONUMENT LOCATION

(Use reverse side if necessary)

Show info such as: History of corner, with reference to Vol. and pg., dates, surveyor; exact description of monument replaced; if location computed, by taped or EDM traverse; landowner, remarks, etc.

SEAL:

NO RECORD FOUND OF CORNER
SINCE THE ORIGINAL SURVEYS;
I ACCEPTED OCCUPATION OF FENCE
FOR N-S LOCATION & PROPORTIONED
IN E-W LOCATION TO $5\frac{1}{4}$ CORNER
OF SEC. 18 & $5\frac{1}{4}$ COR. OF SEC. 17
THIS LOCATION FITS WELL WITH "40"
CORNER TO THE NORTH & OLD
FENCE REMNANTS TO THE SOUTH.

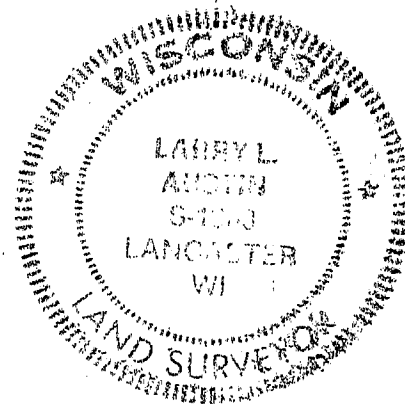

CERTIFIED CORRECT

Registered Land Surveyor

DATE: 8/30/94

TIE SKETCH

Show at least three (3) ties and monument

LEGEND

- ④ GRANT COUNTY ALUM-MON. SET
 ○ 3/4" IRON BAR SET
~~XX FENCE~~

