

REC'D JUL 5 1996

Survey Monument Record

TYPE OF MONUMENT 3/4" x 24" IRON BAR SET

STATE PLANE COORDINATES: N \_\_\_\_\_  
E \_\_\_\_\_


ELEVATION — M.S.L. DATUM: \_\_\_\_\_

THETA ANGLE: \_\_\_\_\_

FIELD BOOK: 95-16

PAGE (5)

CORNER NO. 73  
SECTION 18  
TOWN 5N  
RANGE 3W

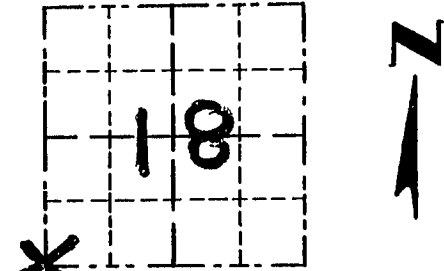


LOCATION  
(Indicated by "X")

BASIS FOR MONUMENT LOCATION

(Use reverse side if necessary)

- NO RECORD FOUND SINCE ORIGINAL SURVEY BY HARVEY PARKE IN 1833.
- CORNER WAS RESET ON THE EAST LINE OF THE SE 1/4 OF SEC. 13, T5N, R4W, AND AT THE RECORDED DISTANCE OF 36 LINKS (23.76') NORTH OF SE COR, SEC 13, T5N, R4W.
- CORNER WAS VERIFIED BY EDM TRAVERSE OF THE AREA.

SEAL:

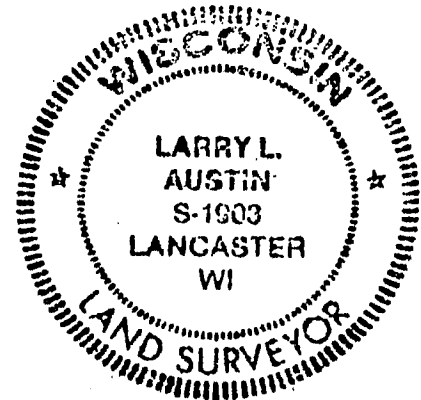

CERTIFIED CORRECT

*Larry L. Austin*  
Registered Land Surveyor

DATE: 3/5/96

TIE SKETCH

Show at least three (3) ties and monument

