

Survey Monument Record

TYPE OF MONUMENT 3/4" x 24" IRON
BAR SET


CORNER NO. 76
SECTION 21
TOWN SN
RANGE 3W

FIELD BOOK: 96-17
PAGE (5)

BASIS FOR MONUMENT LOCATION

(Use reverse side if necessary)


Show info such as: History of corner, with reference to Vol. and pg., dates, surveyor; exact description of monument replaced; if location computed, by taped or EDM traverse; landowner, remarks, etc.

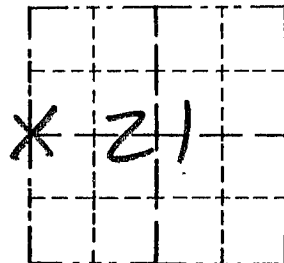

LOCATION
(Indicated by "X")



SEAL:

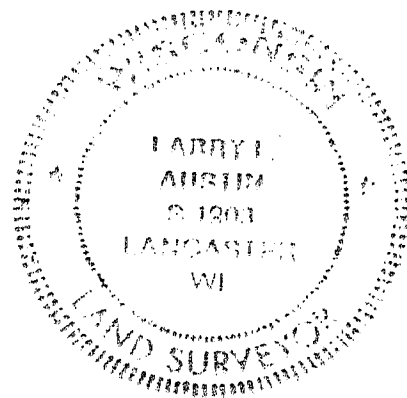

CORNER SET BY HARVEY CLARK. NO RECORD OF CORNER FOUND SINCE ORIGINAL SURVEY; CORNER WAS SET INMIDWAY BETWEEN THE NW AND SW CORNER OF SECTION 21 FOR NORTHING. THE EASTING WAS SET BY A NORTH/SOUTH FENCE. VERIFIED ITS LOCATION USING EDM METHODS.

CERTIFIED CORRECT

Larry L. Austin
Registered Land Surveyor

DATE: 7-30-97

TIE SKETCH

Show at least three (3) ties and monument

