

Survey Monument Record

TYPE OF MONUMENT 3/4" X 24" IRON
BAR SET


CORNER NO. 86
SECTION 22
TOWN 5N
RANGE 3W

FIELD BOOK: 96-17
PAGE (5)

BASIS FOR MONUMENT LOCATION

(Use reverse side if necessary)

Show info such as: History of corner, with reference to Vol. and pg., dates, surveyor; exact description of monument replaced; if location computed, by taped or EDM traverse; landowner, remarks, etc.

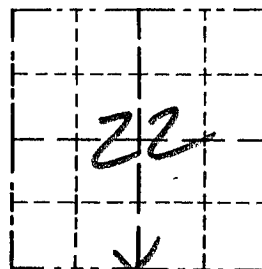


LOCATION

(Indicated by "X")



SEAL:

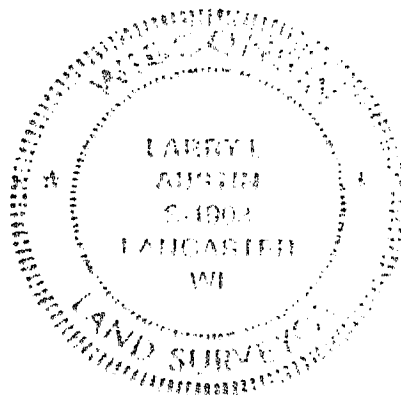

CORNER SET BY HARVEY CLARK. NO RECORD OF CORNER FOUND SINCE ORIGINAL SURVEYS; CORNER SET IN AN EAST/WEST FENCE FOR NOTHING. EASTING ESTABLISHED BY A PROPORTIONED DISTANCE BETWEEN THE SE CORNER OF SECTION 22 AND THE S 1/4 CORNER SECTION 21. VERIFIED ITS LOCATION USING EDM METHODS.

CERTIFIED CORRECT

Larry L. Austin
Registered Land Surveyor

DATE: 7-30-97

TIE SKETCH

Show at least three (3) ties and monument

LEGEND

- ⊕ 3/4" X 24" IRON BAR SET
- 1/2" X 15" IRON BAR SET
- EXISTING FENCE

