

Survey Monument Record

REC'D JAN 29 1995

CORNER NO. 89
 SECTION 28
 TOWN 5N
 RANGE 3W

TYPE OF MONUMENT BASE 2" PIPE POST IN CONC.


STATE PLANE COORDINATES: N _____
 E _____

ELEVATION — M.S.L. DATUM: _____

THETA ANGLE: _____

FIELD BOOK: 95-10

PAGE 24

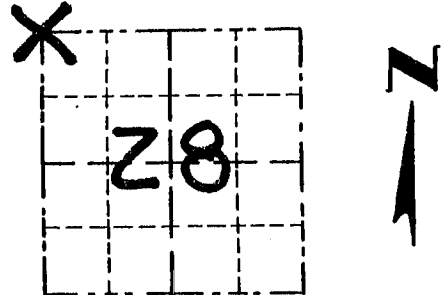

LOCATION
(Indicated by "X")

BASIS FOR MONUMENT LOCATION

(Use reverse side if necessary)

2" IRON PIPE POST FOUND
 AND ACCEPTED AT THE
 OCCUPIED FENCE CORNER
 AND VERIFIED BY EDM
 TRAVERSE OF THE AREA

SEAL:

CERTIFIED CORRECT

Harry L. Aust
 Registered Land Surveyor

DATE: 1/19/96

TIE SKETCH

Show at least three (3) ties and monument

