
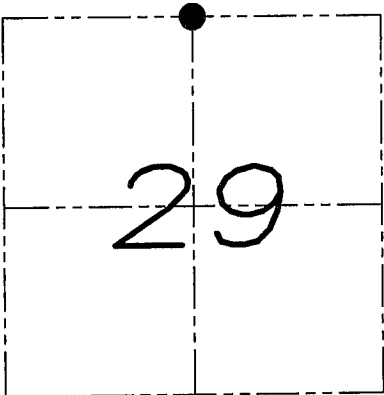


U.S. PUBLIC LAND SURVEY MONUMENT RECORD

Section 29, Town 5 North Range 3 West, Town of North Lancaster, Grant County, Wisconsin

CERTIFICATE

I, Larry L. Austin, do hereby certify that the corner location on this record was determined by me and/or under my direct supervision and that this U.S. public land survey monument record is correct and complete to the best of my knowledge and belief.

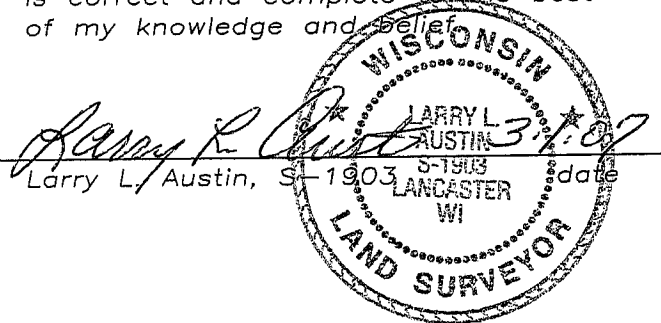

● = CORNER LOCATION

HISTORY OF CORNER


Corner was originally set in 1832 by Parker. No recent record of the corner was found.

CORNER EVIDENCE FOUND

I reset the corner proportionately and on-line between the Northwest and Northeast corners. Verified this location using EDM & GPS methods.

DESCRIPTION OF CORNER AND WITNESS MONUMENTS, references and accessories used to perpetuate the original or re-established location of this corner. Witnesses to monument location Bobby Sedgwick & Brad Digman & Shelby Blindert

SKETCH:

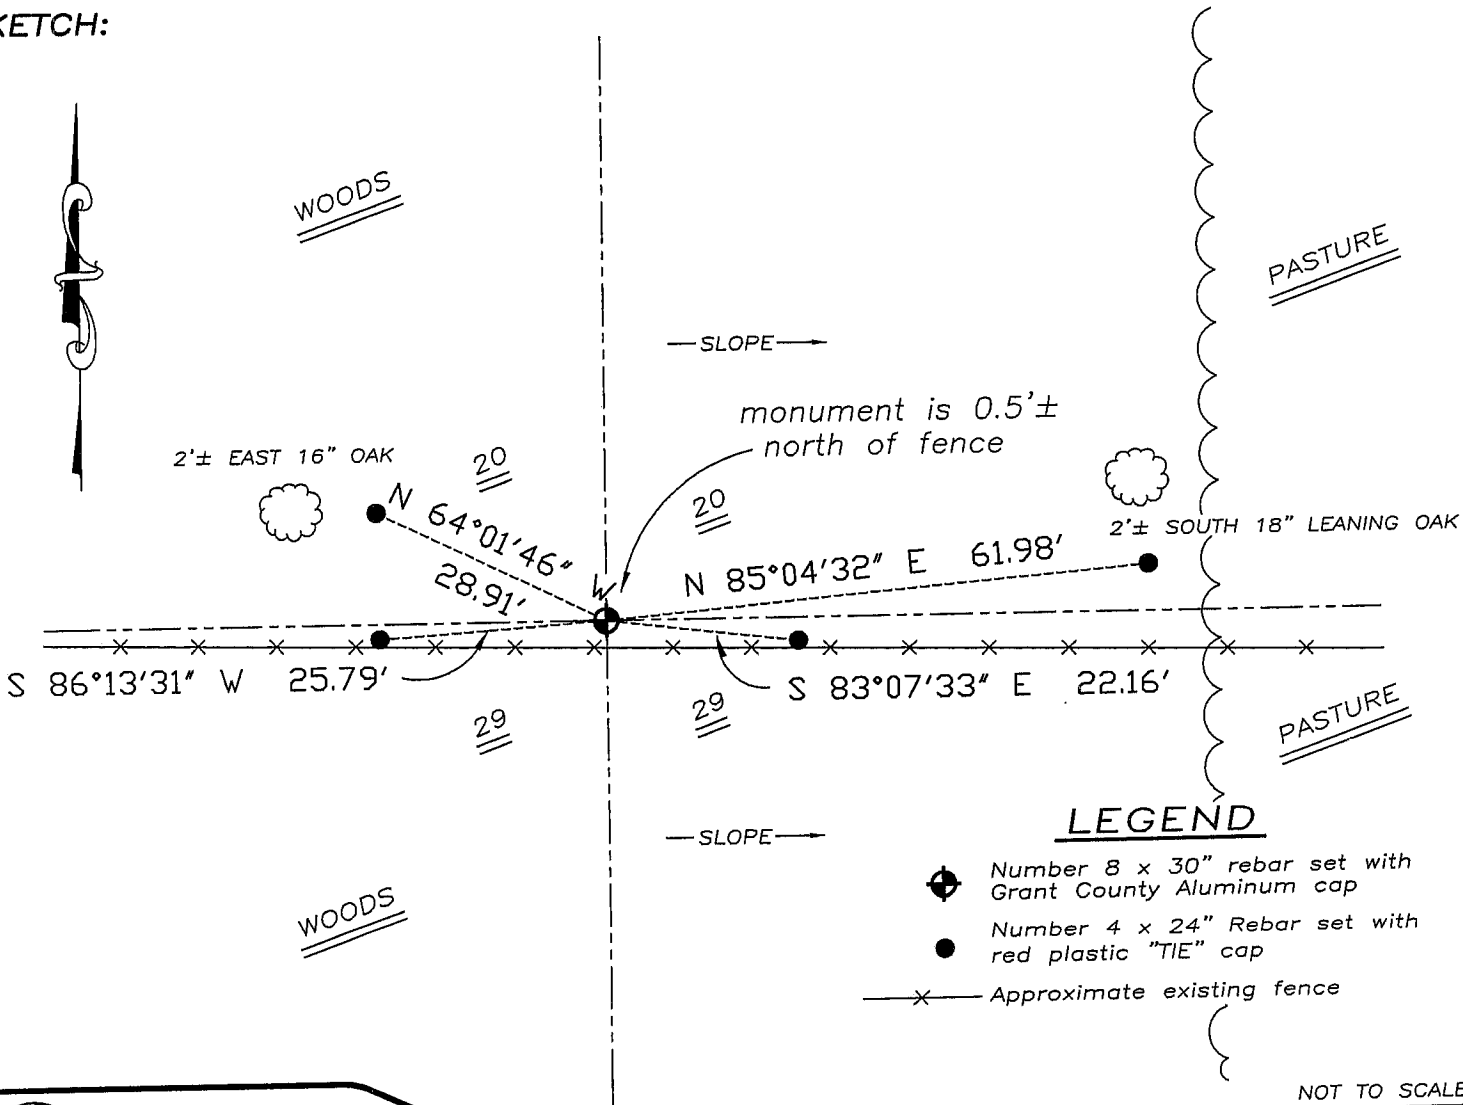

Austin Engineering LLC

4211 HWY 81 E, LANCASTER, WI 53813
PHONE 608-723-6363 FAX 608-723-6702

JOB NUMBER 06S329
FIELDBOOK: TDSR, 2701
G:\T5NR3W\08
H:\TIE\T5NR3W\90

DRAWN BY: BL STANFLEY
APPROVED: LL AUSTIN