

GRANT COUNTY

REC'D JAN 29 1996

Survey Monument Record

TYPE OF MONUMENT 3/4" x 24" IRON BAR SET W/ CAP

STATE PLANE COORDINATES: N _____
E _____


ELEVATION — M.S.L. DATUM: _____

THETA ANGLE: _____

FIELD BOOK: 95-13

PAGE (31)

CORNER NO. 92
SECTION 30
TOWN 5N
RANGE 3W1

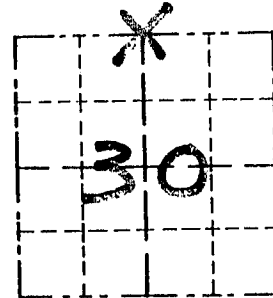

LOCATION
(Indicated by "X")

BASIS FOR MONUMENT LOCATION

(Use reverse side if necessary)

A 3/4" x 24" IRON BAR
WITH ALUMINUM CAP
SET AT PROJECTION OF
FENCE NORTH AND PROJECTION
OF FENCE REMNANTS TO WEST, AFTER
VERIFICATION BY EDM
TRAVERSE OF THE AREA.


SEAL:

CERTIFIED CORRECT

Larry L. Cant
Registered Land Surveyor
DATE: 1/8/96

TIE SKETCH

Show at least three (3) ties and monument

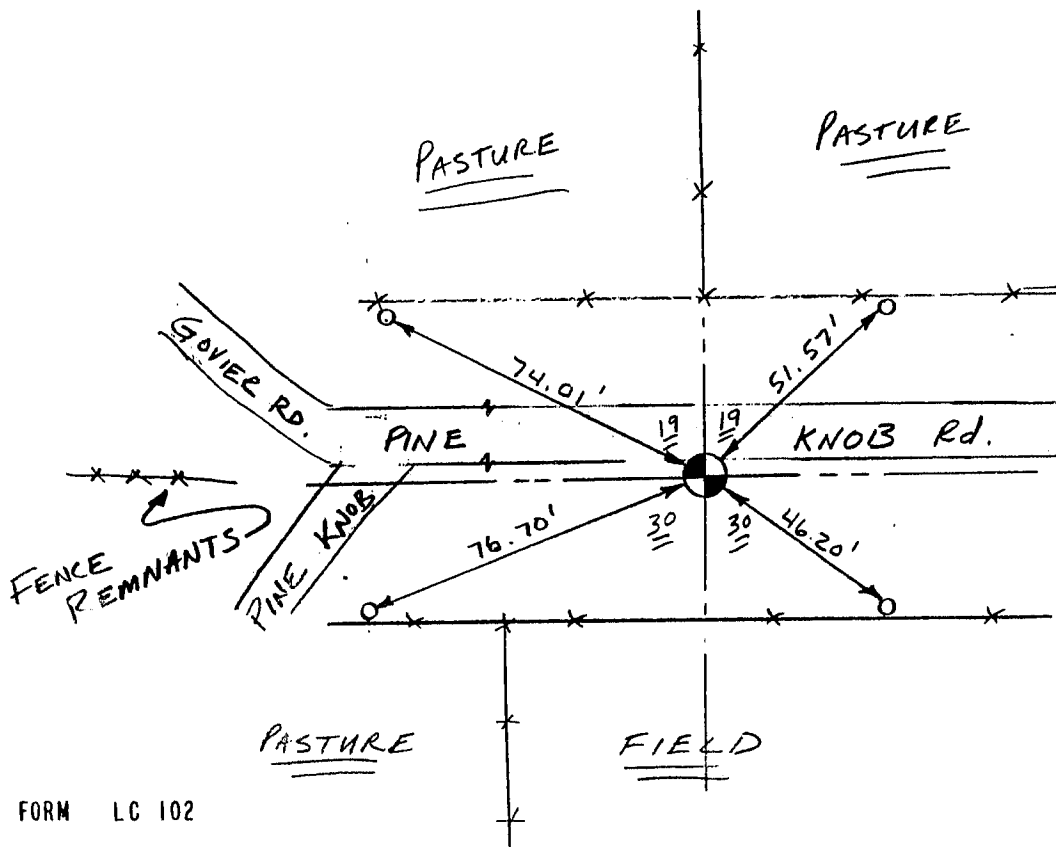

LEGEND

- 3/4" x 24" IBS W/ CAP
- 1" x 12" IRON PIPE SET AS TIES
- EXISTING FENCE