

# GRANT COUNTY

REC'D JAN 29 1996

## Survey Monument Record

TYPE OF MONUMENT GRANT Co. Alum. Mon. SET

STATE PLANE COORDINATES: N \_\_\_\_\_  
E \_\_\_\_\_

ELEVATION — M.S.L. DATUM: \_\_\_\_\_

THETA ANGLE: \_\_\_\_\_


FIELD BOOK: 95-13

PAGE (35)

CORNER NO. 93  
SECTION 30  
TOWN 511  
RANGE 3W

### BASIS FOR MONUMENT LOCATION

(Use reverse side if necessary)

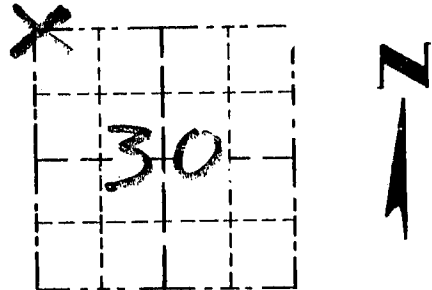

LOCATION  
(Indicated by "X")

GRANT COUNTY MONUMENT SET  
AT RECORDED DISTANCE OF  
6 LINKS SOUTH OF NORTHEAST  
CORNER OF SEC. 25 - T5N R4W,  
AND ON THE EAST LINE OF  
SECTION 25 - T5N R4W.

SEAL:

VERIFIED BY EDM TRAVERSE  
OF THE AREA.

CERTIFIED CORRECT  
*Randy R. Christ*  
Registered Land Surveyor  
DATE: 1/8/96

### TIE SKETCH

Show at least three (3) ties and monument

#### LEGEND

- ⊕ GRANT Co. Alum. MonSET
- 1" x 1/2" IRON PIPESET
- XX EXISTING FENCE
- ( ) RECORDED DIM.

