

GRANT COUNTY

Survey Monument Record

TYPE OF MONUMENT 3/4" X 24" IRON BAR

STATE PLANE COORDINATES: N SET
E _____

ELEVATION — M.S.L. DATUM: _____

THETA ANGLE: _____

FIELD BOOK: 95-14


PAGE _____

CORNER NO. 102

SECTION 25

TOWN 5N

RANGE 3W

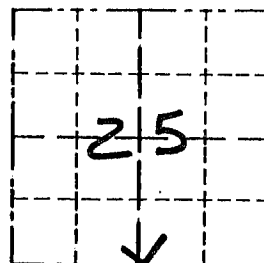


LOCATION
(Indicated by "X")



BASIS FOR MONUMENT LOCATION

(Use reverse side if necessary)

CORNER SET IN 1832
BY HARVEY CLARKE.
IN 1983 DOUGLAS MALLIET SEAL:
SET A 2" IRON PIPE, BASED ON
HIS LOCATION OF THE SW CORNER.
I RE-ESTABLISHED THE S 1/4
CORNER MIDWAY & ON LINE BETWEEN
THE SE & SW CORNERS OF THE
SECTION. VERIFIED THIS LOCATION
BY EDM METHODS.

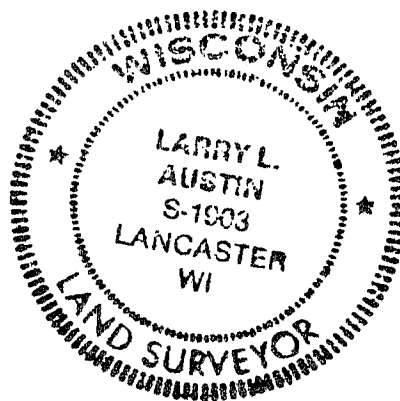

CERTIFIED CORRECT

Larry L. Austin
Registered Land Surveyor


DATE: 8-31-96

TIE SKETCH

Show at least three (3) ties and monument.

LEGEND

- ⊕ 3/4" X 24" IRON BAR SET
- 1/2" X 18" IRON BAR
- ▲ 2" IRON PIPE END
- ⚡ POWER POLE W/ SPIKE SET BY MALLIET

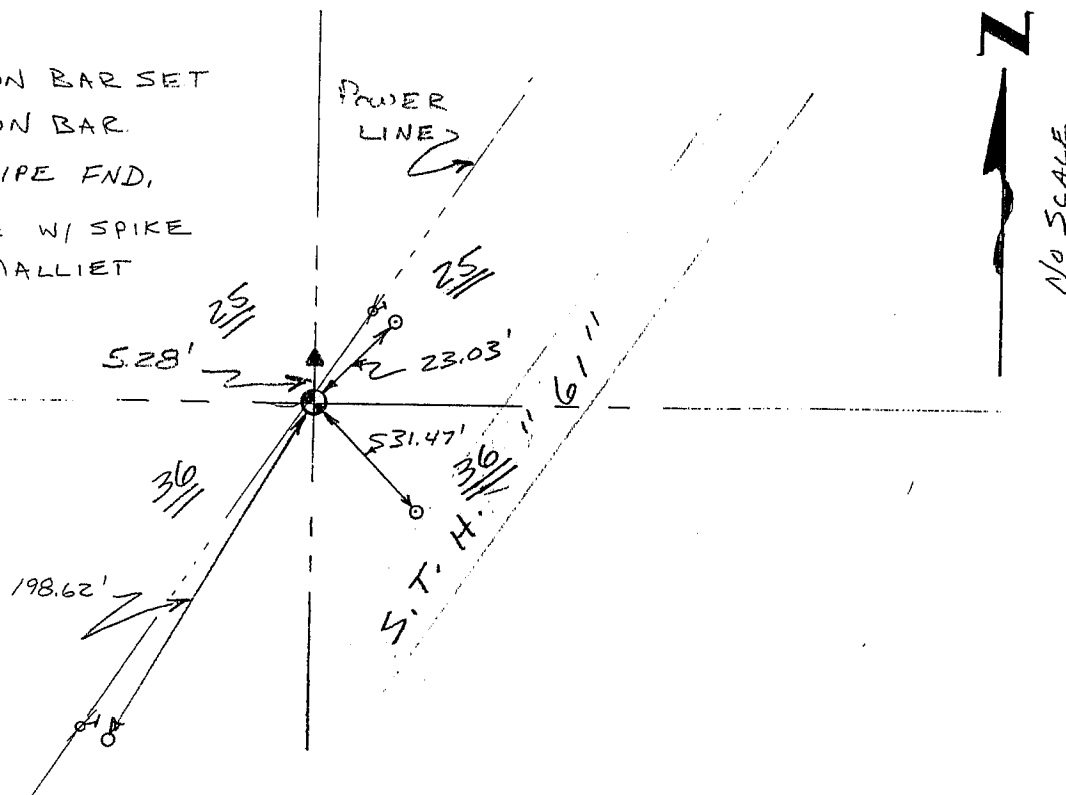

US. PUBLIC LAND SURVEY MONUMENT RECORD

CORNER DESCRIPTION: 5/4 CORNER, SECTION 25, T 5 N, R 3 W

STATE PLANE COORDINATES: N _____, E _____

THETA ANGLE: _____


HORIZONTAL DATUM: WISCONSIN STATE PLANE COORDINATE SYSTEM, SOUTH ZONE

EVIDENCE: No CRATER Penetration of RECORD - OCCUPATION UTILIZED TO ESTABLISH THE SW & SE SECTION GRADINGS OF 2.5: 8% CRATER SET AT PROPORTED DISTANCE

MONUMENT: FOUND ☐ , PLACED ☒
METHOD OF RESTORATION(RE-ESTABLISHMENT):
☐ ACCEPTED EXISTING MONUMENT
N ☐ , E ☐ ACCEPTED OCCUPATION
N ☐ , E ☒ LOST CORNER PROPORTIONATE METHODS
DATE CORNER SET: 4-8-83

LEGEND

- ▲ SET #6 REBAR, 113 LBS PER LINEAL FT. MIN. WT.
- SET 1" X 24" IRON PIPE, 113 LBS. PER LINEAL FT. MIN. WT.
- SET 2" X 30" IRON PIPE, 3.65 LBS. PER LINEAL FT. MIN. WT.
- FOUND 1" IRON PIPE
- FOUND 2" IRON PIPE
- FOUND R/R SPIKE
- SET R/R SPIKE
- ◉ GOVERNMENT CORNER
- EXISTING FENCE

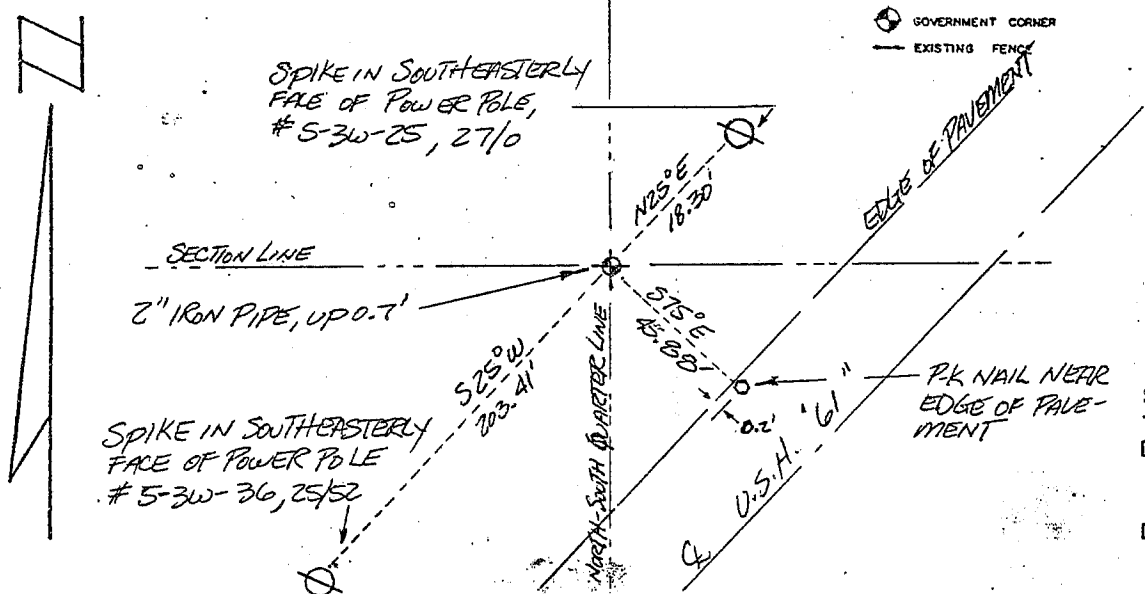

SECTION 25
T SN. R 3W

NOT TO SCALE THIS CONFORMS TO WISCONSIN ADMINISTRATIVE CODE A-E 5.02


SURVEYOR'S AFFIDAVIT:

STATE OF WISCONSIN)
GRANT COUNTY) SS

I hereby certify that I, DOUGLAS J. MALLIET, have complied with the Wisconsin State Statutes, Statutes of the United States, and the rules and regulations made by the Secretary of the Interior in the location of the corner shown above.

DATE OF SURVEY: 4-8-83

Douglas J. Mellick
REGISTERED LAND SURVEYOR
9266

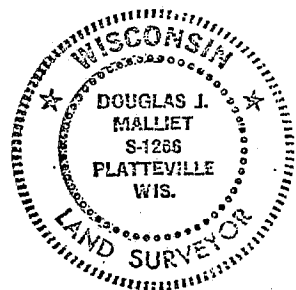

D. F. BURBACH MUNICIPAL & CIVIL ENGINEERS

410 NORTH SECOND STREET • PLATTEVILLE, WISCONSIN 53818 • (608) 348-3262

MAY 24 1963

P. 102