


GRANT COUNTY

U.S. PUBLIC LAND SURVEY MONUMENT RECORD

Southwest Corner of Section 25
T 5 N, R 3 W, Town of North Lancaster

Type of monument: 3/4" Iron Bar with Grant County Aluminum Cap

Location indicated on sketch - ■

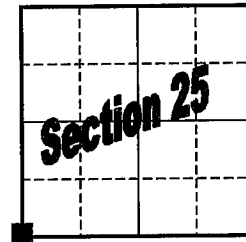

T 5 N, R 3 W

Describe and record evidence, monument evidence, occupational evidence, testimonial evidence or any other material evidence you considered, and whether the monument was found or placed.

Re-established corner location according to survey by Douglas Malliet recorded at Book I, Page 66.

The 2" iron pipe set by Malliet during said survey no longer existed. The only tie remaining from Malliet's tie sheet was an 18" oak to the Southwest. Malliet had given a distance to the face of said tree as a tie. Said oak was found standing. However, the tree was dead and leaning slightly to the Northeast.


Re-established the corner location at recorded distance of 887 feet from an existing 1" iron pipe found at a property corner East of the Section corner. Said pipe being also from Malliet's survey. Extended direction from an existing 2" iron pipe at the South 1/4 corner of Section 25, as established by Malliet, Westerly through said 1" iron pipe.

(Note: In 1996, Larry Austin disagreed with the South 1/4 corner as set by Malliet and monumented the South 1/4 corner with a 3/4" iron bar. Malliet's 2" iron pipe at the South 1/4 corner has been used in this re-establishment only as a means of retracing the location of the Southwest corner of Section 25.)

Note: While digging for Malliet's pipe, found a great amount of very old wire (barbed & non-barbed) at the location.

Grant County Coordinates (survey feet): N=532309.319 E=825876.428

Show a plan view drawing depicting the relevant monuments, providing reference ties to at least four witness monuments. Describe witness monuments. Show relationship to occupation.

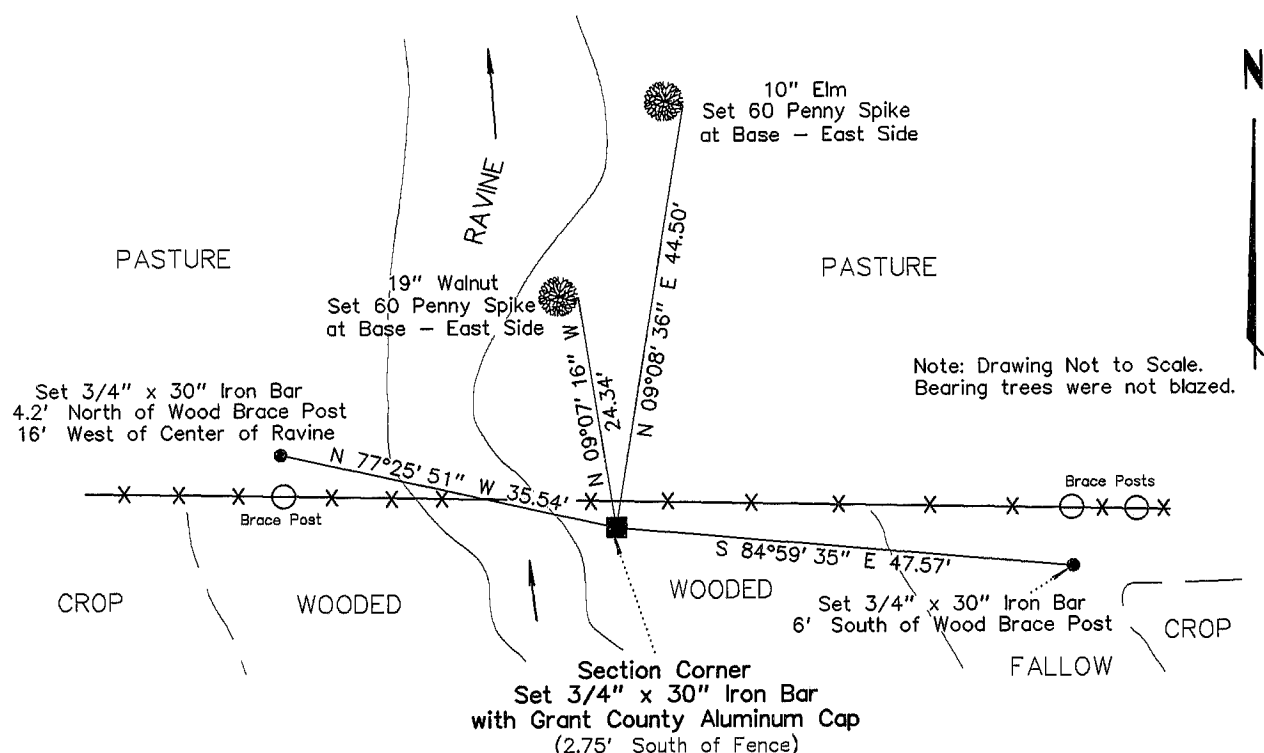

Describe any material discrepancy between the location of the corner as restored or reestablished and the location of that corner as previously restored or reestablished by distance and direction. Show the discrepancy on the plan view drawing. Show the distances between the corner as restored or reestablished, and (1) the corner as previously restored or reestablished – and (2) to at least two of the witness monuments shown on the previous drawing.

N/A

Was the corner restored through acceptance of (1) an obliterated evidence location, (2) a found perpetuated location, or (3) an existent corner location.

(2) a found perpetuated location

* as per existing monuments from survey of record

Was the corner reestablished through lost corner proportionate methods? If so, show the method including the directions to other public land survey corners used as evidence or used for proportioning in determining the corner location.


N/A

Show the history of record in chronological order from Original Government Survey to present.

- (1) Original corner established by Parke, 1832.
- (2) Douglas Malliet of D.F.Burbach Municipal & Civil Engineers re-established the corner location by evidence of occupation and set a 2" iron pipe in 1983.
(Survey recorded as Book I, Page 66 – Tie Sheet recorded at Page 103)

I, Jessica A. Zamor, do hereby certify that the corner location shown on this record was determined by me or under my direction and control and that this U.S. Public Land Survey Monument Record is correct to the best of my knowledge and belief.

Jessica A. Zamor 5-11-2000
Jessica A. Zamor R.L.S. S-2310 Date

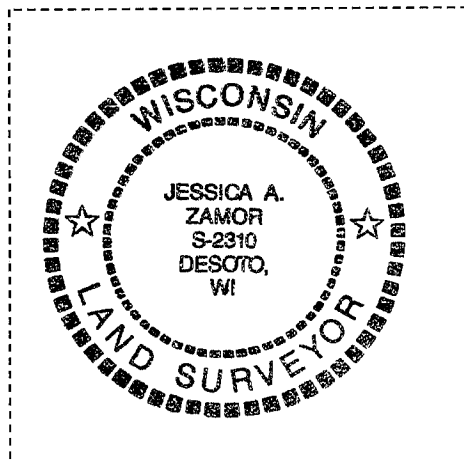

North Lancaster Township

US. PUBLIC LAND SURVEY MONUMENT RECORD

CORNER DESCRIPTION: SW CORNER, SECTION 25, T 5 N, R 3 W

STATE PLANE COORDINATES: N _____, E _____

THETA ANGLE: _____

HORIZONTAL DATUM: WISCONSIN STATE PLANE COORDINATE SYSTEM, SOUTH ZONE

EVIDENCE: FOUND NORTH, SOUTH & WEST ANCIENT FENCE LINES & REMNANTS OF CORNER POST IN GROUND @ FENCE INTERSECTION; NO GRAVEL MONUMENT ON RECORD

MONUMENT: FOUND ☐, PLACED ☒

METHOD OF RESTORATION (RE-ESTABLISHMENT):

☐ ACCEPTED EXISTING MONUMENT



N ☒, E ☒ ACCEPTED OCCUPATION

N ☐, E ☐ LOST CORNER PROPORTIONATE METHODS

DATE CORNER SET: 2-25-83

LEGEND

- ▲ SET #6 REBAR, 113 LBS PER LINEAL FT. MIN. WT.
- SET 1" X 24" IRON PIPE, 113 LBS PER LINEAL FT. MIN. WT.
- SET 2" X 30" IRON PIPE, 3.65 LBS. PER LINEAL FT. MIN. WT.
- FOUND 1" IRON PIPE
- FOUND 2" IRON PIPE
- FOUND R/R SPIKE
- SET R/R SPIKE
- ⊙ GOVERNMENT CORNER
- EXISTING FENCE

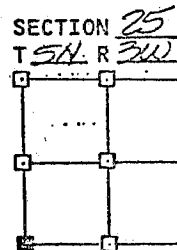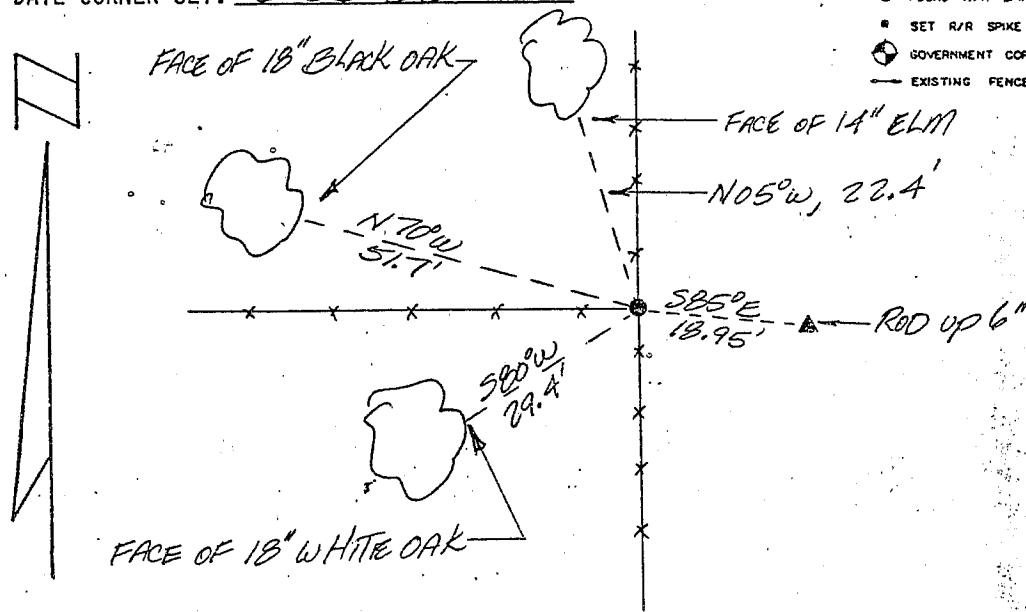

NOT TO SCALE THIS CONFORMS TO WISCONSIN ADMINISTRATIVE CODE A-E 5.02


SURVEYOR'S AFFIDAVIT:

STATE OF WISCONSIN)
GRANT COUNTY) SS

I hereby certify that I, DOUGLAS J. MALLIET, have complied with the Wisconsin State Statutes, Statutes of the United States, and the rules and regulations made by the Secretary of the Interior in the location of the corner shown above.

DATE OF SURVEY: 3-5-83

Douglas J. Malliet
REGISTERED LAND SURVEYOR
1260

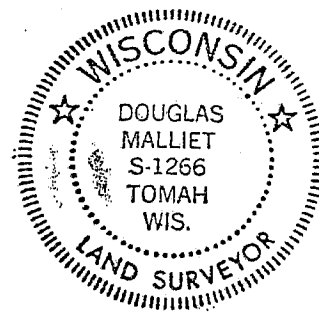

D. F. BURBACH MUNICIPAL & CIVIL ENGINEERS

410 NORTH SECOND STREET • PLATTEVILLE, WISCONSIN 53818 • (608) 348-3262

MAY 24 1983

25103