

GRANT COUNTY

REC'D JAN 29 1996

Survey Monument Record

TYPE OF MONUMENT GRANT Co. Alum. Mon. SET

STATE PLANE COORDINATES: N _____
E _____

ELEVATION — M.S.L. DATUM: _____

THETA ANGLE: _____

FIELD BOOK: 95-13

PAGE (31)

CORNER NO. 111


SECTION 30

TOWN 5N

RANGE 3W

BASIS FOR MONUMENT LOCATION

(Use reverse side if necessary)

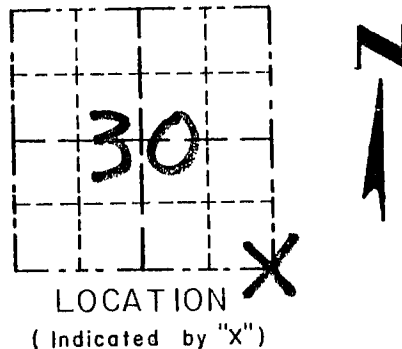

LOCATION (Indicated by "X")

SEAL:

GRANT COUNTY ALUMINUM
MONUMENT SET AT
OCCUPIED FENCE CORNER
AFTER VERIFICATION BY EDM
TRAVERSE OF THE AREA

CERTIFIED CORRECT

Randy R. Hunt
Registered Land Surveyor

DATE: 1/8/96

TIE SKETCH

Show at least three (3) ties and monument

LEGEND



GRANT COUNTY Alum.
MON. SET

O 1"X12" IRON PIPE PLACED AS TIE PASTURE

--- EXISTING FENCE

