

REC'D JAN 29 1996

GRANT COUNTY


Survey Monument Record

TYPE OF MONUMENT 3/4" x 24" IRON BAR SET
 STATE PLANE COORDINATES: N _____
 E _____
 ELEVATION — M.S.L. DATUM: _____
 THETA ANGLE: _____
 FIELD BOOK: 95-13
 PAGE: (32)

CORNER NO. 112
 SECTION 30
 TOWN 5N
 RANGE 3W

BASIS FOR MONUMENT LOCATION

(Use reverse side if necessary)

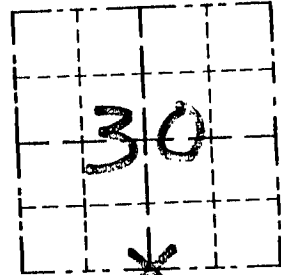

LOCATION
 (Indicated by "X")

A 3/4" x 24" IRON BAR SET
 18" BELOW SURFACE MIDWAY
 AND ON LINE BETWEEN
 SOUTHWEST COR AND SOUTHEAST
 CORNER OF SECTION 30 AFTER
 VERIFICATION BY EDM TRAVERSE
 OF THE AREA

SEAL:

CERTIFIED CORRECT

Randy P. Curtis
 Registered Land Surveyor

DATE: 1/8/96

TIE SKETCH

Show at least three (3) ties and monument

