

Survey Monument Record

CORNER NO. 113
SECTION 30
TOWN 5N
RANGE 3W


TYPE OF MONUMENT 3/4" x 24" IRON BAR SET
STATE PLANE COORDINATES: N _____
E _____

ELEVATION - M.S.L. DATUM: _____

THETA ANGLE: _____

FIELD BOOK: 95-13

PAGE 32

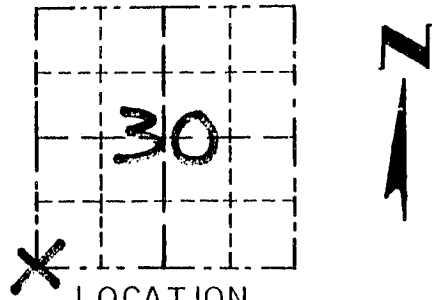


BASIS FOR MONUMENT LOCATION

(Use reverse side if necessary)

SEAL:

3/4" x 24" IRON BAR SET
AT RECORDED DIM. OF
24 LINKS SOUTH OF SE COR
25-T5N, R4W AND ON LINE
WITH PROJECTION OF FENCE
REMNANTS SOUTH AND 40 COR
TO NORTH AND VERIFIED BY
EDM TRAVERSE OF THE
AREA

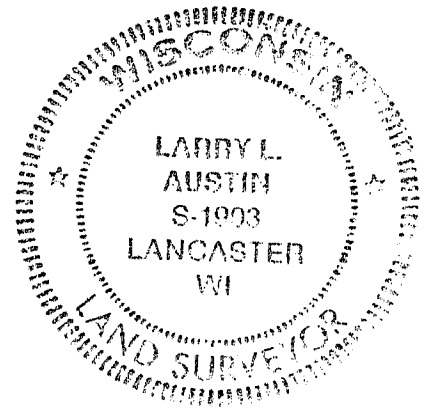

CERTIFIED CORRECT

Larry L. Austin
Registered Land Surveyor

DATE: 1/8/96

TIE SKETCH

Show at least three (3) ties and monument

