


Grant County Section Data Sheet

Section 25, Town 5 North, Range 3 West

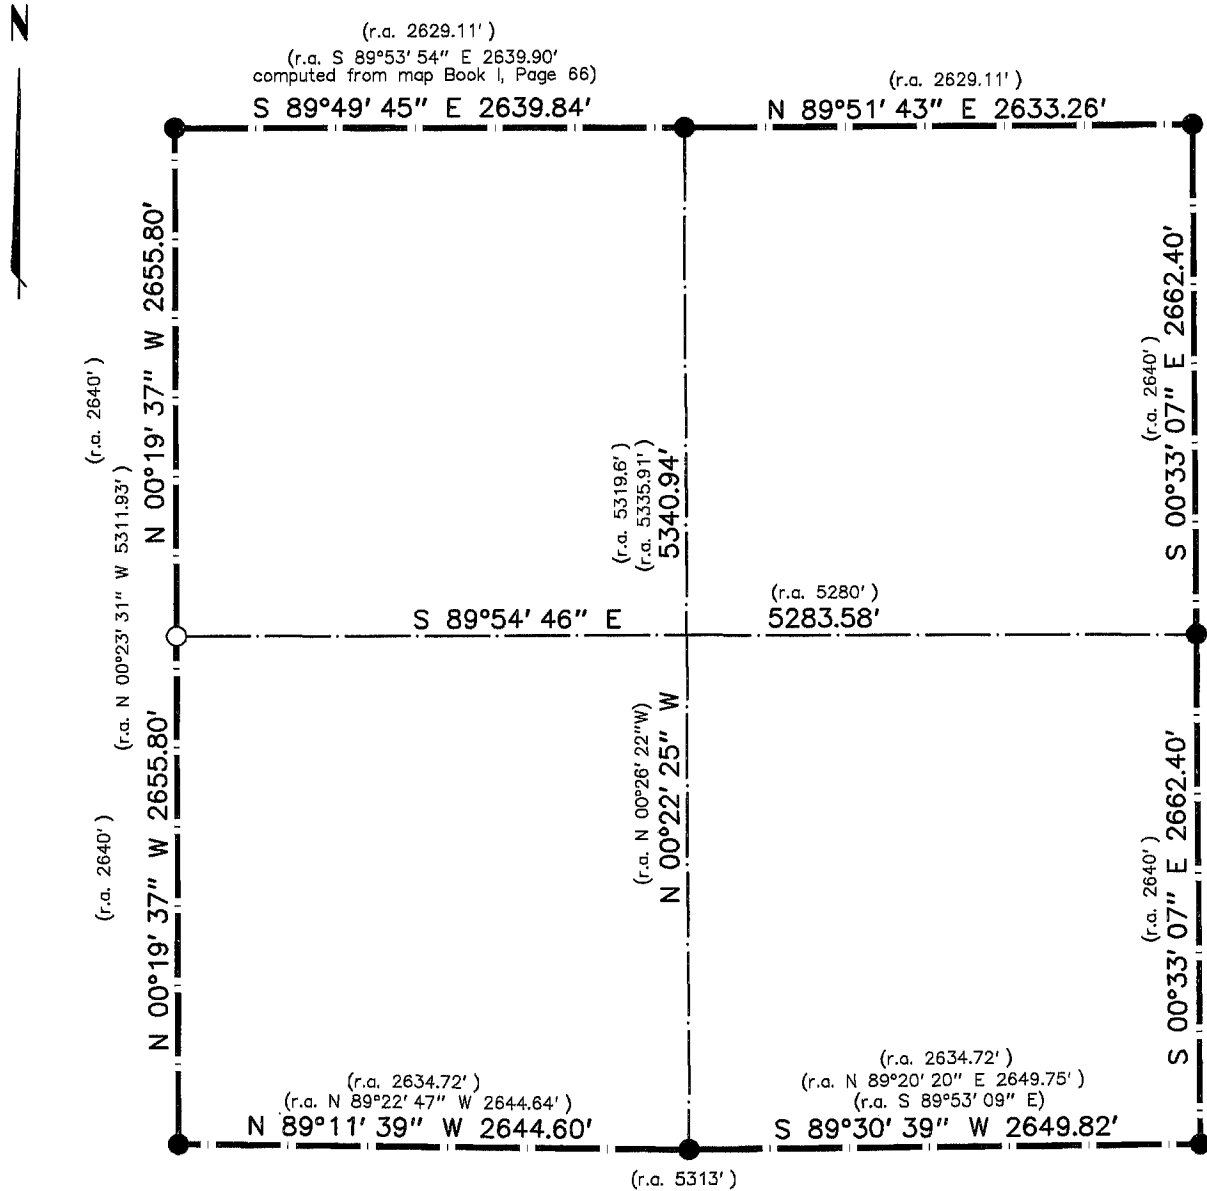

Bearings referenced to Grid North, Grant County Coordinate System.

	CORNER	DESCRIPTION OF MONUMENT
<p style="font-family: cursive; font-size: 1.2em; margin: 0;"><i>Jessica A. Zamor</i></p> <p style="margin: 0;">SURVEYOR'S SIGNATURE</p> <p style="margin: 5px 0 0 0;">DATE: <u>5-11-2000</u></p> <p style="margin: 0;">LAND SURVEYOR SEAL</p>	NW CORNER	Existing 2" Iron Pipe
	NORTH 1/4	Existing 2" Iron Pipe
	NE CORNER	Set 3/4" Iron Bar w/ Grant County Aluminum Cap
	EAST 1/4	Set 3/4" Iron Bar w/ Grant County Aluminum Cap
	SE CORNER	Existing 3/4" Iron Bar (established by Larry Austin)
	SOUTH 1/4	Existing 3/4" Iron Bar (established by Larry Austin)
	SW CORNER	Set 3/4" Iron Bar w/ Grant County Aluminum Cap
	WEST 1/4	Set 3/4" Iron Bar w/ Grant County Aluminum Cap