


U.S. PUBLIC LAND SURVEY MONUMENT RECORD - GRANT COUNTY, WI

Summary of Section 26, Town 5 North Range 3 West, Town of North Lancaster

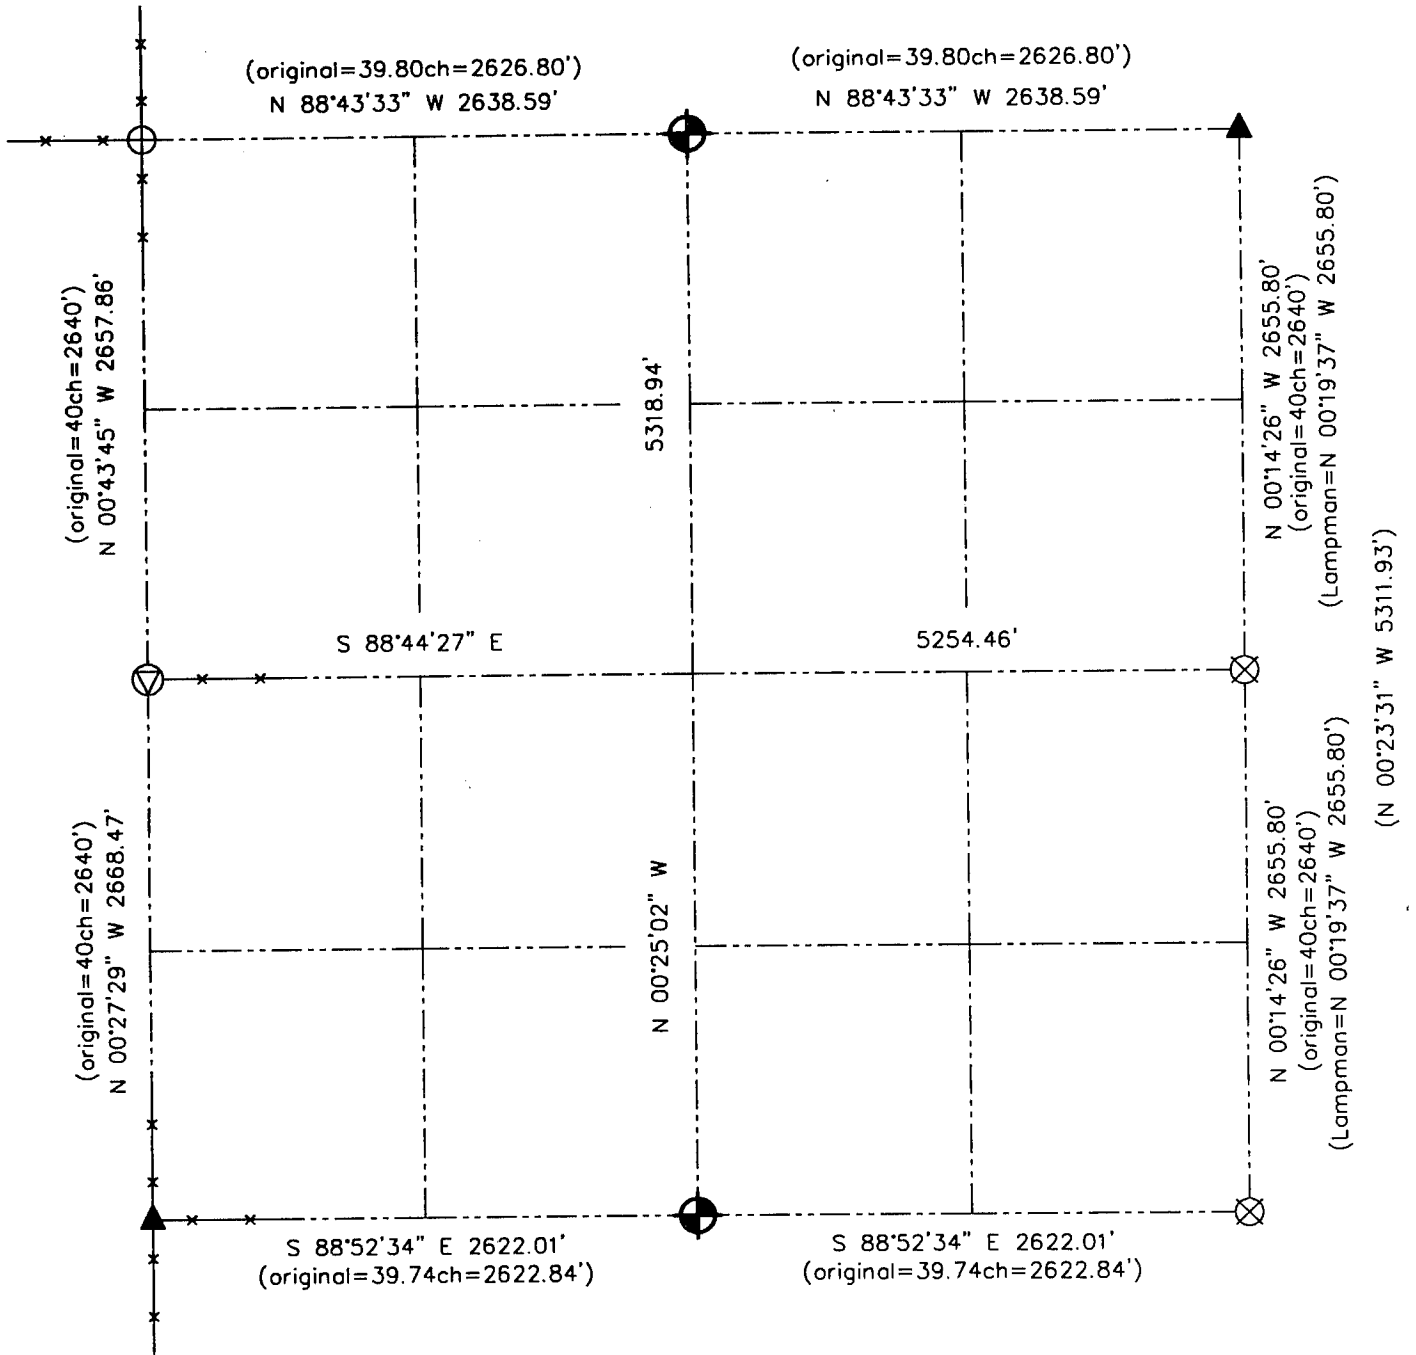


LEGEND

- NUMBER 8 x 30" REBAR SET WITH GRANT COUNTY ALUMINUM CAP
- NUMBER 8 REBAR FOUND WITH GRANT COUNTY ALUMINUM CAP
- NUMBER 6 REBAR FOUND WITH GRANT COUNTY ALUMINUM CAP
- RAILROAD SPIKE FOUND
- 2" IRON PIPE FOUND
- () RECORDED AS



Relationship of all section corners to other section corners shall be shown hereon by bearing and distance or grid coordinates. Bearing reference shown below.

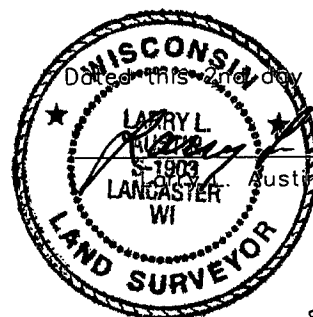

Dated this 2nd day of April, 2001

Larry L. Austin
Austin S-1903

SKETCH NOT TO SCALE

AUSTIN ENGINEERING, LLC

4211 HWY 81 EAST, LANCASTER, WI 53813
PHONE 608-723-6363 FAX 608-723-6702

FIELDBOOK: SDR33, 2102
G:\T5NR3W\27
C:\SWA\TIE\T5NR3W\26SUM

CREW: BS-SB-SA-TF
DRAWN BY: SW AUSTIN
APPROVED: LL AUSTIN