

54016.5

U.S. PUBLIC LAND SURVEY MONUMENT RECORD - GRANT COUNTY, WI

Section 4, Town 5 North Range 4 West, Town of Little Grant (a)


NOTE: This form is intended and designed to fulfill all requirements of the Wisconsin Administrative Code Chapter A-E 7.08, U.S. Public Land Survey Monument Record (3) (a) (b) (c) (d) (e) (f) (g) (h) (i).

CERTIFICATE: (i)

I, Aaron J. Austin, Wisconsin Professional Land Surveyor, do hereby certify that the corner location on this record was determined by me and/or under my direct supervision and that this U.S. Public Land Survey Monument Record is correct and complete to the best of my knowledge and belief.

Dated this 20th day of April, 2023.

Aaron J. Austin
Aaron J. Austin, S-2922

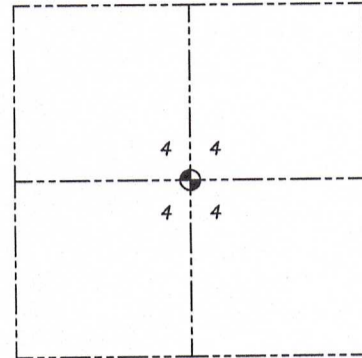

⊙ = CORNER LOCATION

Grant County Coordinates:
NAD 83 (2011)
Northing: 556,609.51
Easting: 780,655.29

HISTORY OF CORNER ESTABLISHMENT:

Original corner was not set with the Original Government Survey.
Douglas Malliet set the Southwest Corner of the SE 1/4 of the NW 1/4 on a Survey dated 11-30-1988 and filed in Book L, Page 359.

DESCRIPTION OF CORNER EVIDENCE FOUND: (b) (f) (g) (h)

I established the Center of Section 4 by measuring the West 1/4 corner and Southwest corner of the SE 1/4 of the NW 1/4 and doubling that distance to the East and put the Corner online between the East 1/4 corner and the West 1/4 corner. I set four witness corners after I verified the Monument's location with G.P.S. and E.D.M. methods.

DESCRIPTION OF CORNER AND WITNESS MONUMENTS, references and accessories used to perpetuate the original or re-established location of this corner. (c) (d) (e)

Witnesses to corner location Owen Austin, Tanner Austin.
Drawn by: Owen Austin.

SKETCH:

LEGEND

- ⊙ Section Corner—as designated
- 3/4" rebar found
- 1/2" x 18" rebar set
- x-x-x- Existing fence
- ~~~~~ Edge of field

WEST 1/4 CORNER
SECTION 4, T5N R4W
2" Iron Pipe found

