


REC'D JUL 5 1996

Survey Monument Record

CORNER NO. 60  
SECTION 13  
TOWN 5N  
RANGE 4W

TYPE OF MONUMENT COUNTY MONUMENT SET  
STATE PLANE COORDINATES: N \_\_\_\_\_  
E \_\_\_\_\_  
ELEVATION — M.S.L. DATUM: \_\_\_\_\_  
THETA ANGLE: \_\_\_\_\_  
FIELD BOOK: 95-16  
PAGE (5)

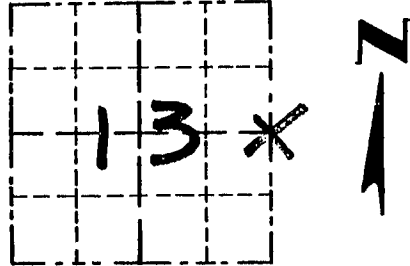


LOCATION  
(Indicated by "X")

BASIS FOR MONUMENT LOCATION

(Use reverse side if necessary)

- TOWNSHIP LINE WAS ORIGINALLY SURVEY 1832 by Sibley,  
- NO RECORD OF CORNER FOUND SINCE ORIGINAL SURVEYS  
- N-S LOCATION DETERMINED BY DOUBLING "40" FROM SOUTH; E-W LOCATION BASED FOUND OCCUPATION;  
VERIFIED THIS LOCATION BY EDM TRAVERSE OF THE ARPA

SEAL:

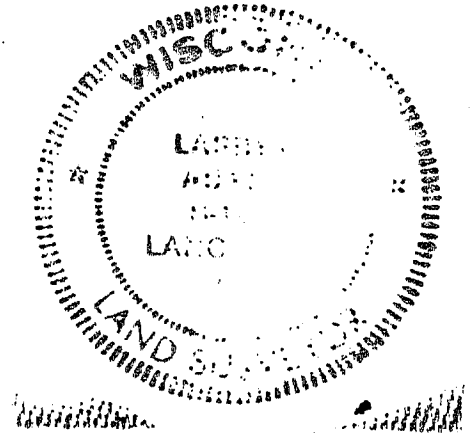

CERTIFIED CORRECT

*Harry R. Aust*  
Registered Land Surveyor

DATE: 3-5-96

TIE SKETCH

Show at least three (3) ties and monument

LEGEND

⊕ COUNTY MONUMENT SET

○ 1" x 12" IRON PIPE SET

\* \* \* EXISTING FENCE

