

**U.S. PUBLIC LAND SURVEY MONUMENT RECORD - GRANT COUNTY, WI**

Section 22, Town 5 North Range 4 West, Town of Little Grant (a)


NOTE: This form is intended and designed to fulfill all requirements of the Wisconsin Administrative Code Chapter A-E 7.08, U.S. Public Land Survey Monument Record (3) (a) (b) (c) (d) (e) (f) (g) (h) (i).

**CERTIFICATE: (i)**

I, Aaron J. Austin, Wisconsin Professional Land Surveyor, do hereby certify that the corner location on this record was determined by me and/or under my direct supervision and that this U.S. Public Land Survey Monument Record is correct and complete to the best of my knowledge and belief.

Dated this 13th day of March, 2023.

*Aaron J. Austin*  
 Aaron J. Austin, S-2922

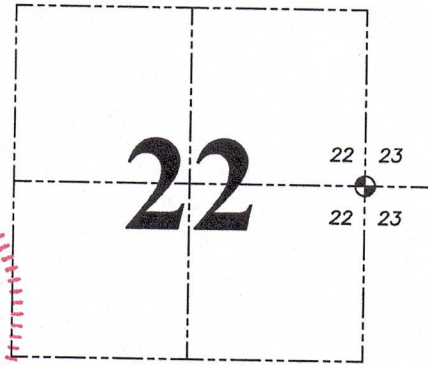

Grant County Coordinates:  
 NAD 83 (2011)  
 Northing: 540,661.71  
 Easting: 788,737.06

⊕ = CORNER LOCATION

**HISTORY OF CORNER ESTABLISHMENT:**

Original corner was set in 1833 by Harvey Parke.  
 No other Record of this corner being set was found.

**DESCRIPTION OF CORNER EVIDENCE FOUND: (b) (f) (g) (h)**

I found no evidence of the original corner. I set a 1 1/4" x 24" Rebar midway between the Northeast and Southeast Corners of Section 22 and midway between the occupied 40 fences to the East and the West. This fit well with the original creek call to the South of the Corner. I set four witness corner After I verified the Monument's location with G.P.S. and E.D.M. methods.

**DESCRIPTION OF CORNER AND WITNESS MONUMENTS, references and accessories used to perpetuate the original or re-established location of this corner. (c) (d) (e)**

Witnesses to corner location Shane Austin, Owen Austin, Tanner Austin.  
 Drawn by: Owen Austin.

SKETCH:

**LEGEND**

- ⊕ Section Corner—as designated
- 3/4" x 18" rebar set
- x-x-x- Existing fence

