

U.S. PUBLIC LAND SURVEY MONUMENT RECORD - GRANT COUNTY, WI



Section 30, Town 5 North Range 4 West, Town of Little Grant

CERTIFICATE:

I, Jimmy D. Rose, do hereby certify that the corner location on this record was determined by me and/or under my direct supervision and that this U.S. Public Land Survey Monument Record is correct and complete to the best of my knowledge and belief.

Dated this 21st day of December, 2012

Jimmy D. Rose
 Jimmy D. Rose S-1911

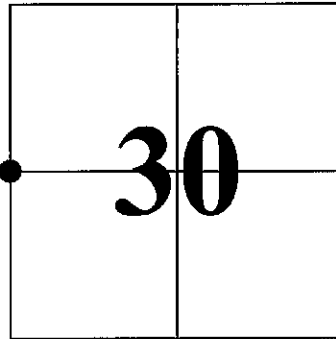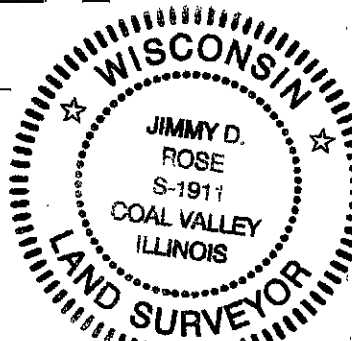

● = CORNER LOCATION

HISTORY OF CORNER ESTABLISHMENT: NO RECORD OF CORNER BEYOND ORIGINAL GOVERNMENT SURVEYS WAS UNCOVERED.

DESCRIPTION OF CORNER EVIDENCE FOUND: ESTABLISHED CORNER LOCATION USING GLO PLAT. LOCATION IS SUPPORTED BY TRAVERSE TO ADJOINING CORNERS.

DESCRIPTION OF CORNER AND WITNESS MONUMENTS, references and accessories used to perpetuate the original or re-established location of this corner.

SKETCH:

LEGEND

- ▲ FOUND GRANT COUNTY MONUMENT
- △ FOUND 3/4" DIA. REBAR
- SET 5/8" DIA. REBAR

