

GRANT COUNTY

REC'D JAN 29 1996

Survey Monument Record

TYPE OF MONUMENT GRANT Co. Alum. Mon Set

STATE PLANE COORDINATES: N _____
E _____

ELEVATION — M.S.L. DATUM: _____

THETA ANGLE: _____

FIELD BOOK: 95-13


PAGE (36)

CORNER NO. 100

SECTION 25

TOWN 5 N

RANGE 4 W

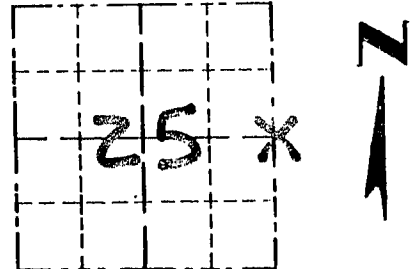

LOCATION

(Indicated by "X")

BASIS FOR MONUMENT LOCATION

(Use reverse side if necessary)

GRANT COUNTY MONUMENT WAS SET IN A NORTH-SOUTH SEAL: FENCE LINE FOR E-W LOCATION AND MIDWAY BETWEEN NE COR 25 AND SE COR 25 FOR N-S LOCATION AFTER VERIFICATION BY EDM TRAVERSE OF THE AREA.

CERTIFIED CORRECT

Larry J. Rust
Registered Land Surveyor

DATE: 1/8/96

TIE SKETCH

Show at least three (3) ties and monument

LEGEND

⊙ GRANT COUNTY ALUM. MON. SET

○ 1"X12" IRON PIPE SET

— X — EXISTING FENCE

